


STATE OF MICHIGAN
DEPARTMENT
OF
NATURAL RESOURCES

LAND CORNER RECORD

ANTRIM COUNTY
T 31 N R 5 W

DESCRIPTION OF CORNER S 1/4 corner of Section 1
CORNER MONUMENT Set DNR Monument
DATE MONUMENT PLACED AND WITNESSED 10-20-71
WITNESSES TO CORNER..... 5" Maple Twin N 50 E 24.0'

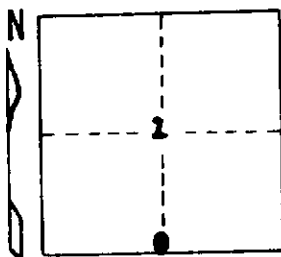


8" Maple S 27 E 10.9'
6" Maple N 88 E 38.0'
AND

CIRCLE CORNER REGISTERED

DESCRIPTION IN DETAIL AS TO HOW CORNER WAS LOCATED AND IDENTIFIED OR RESTORED.

Corner reestablished per standard BLM instructions, which fits U.S. tie to base of hill, 1 chain East.

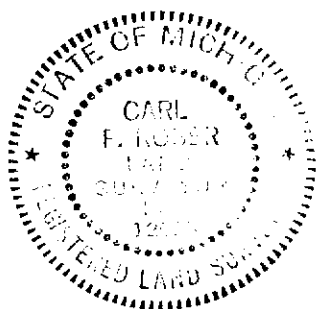

SURVEYOR'S SEAL

SIGNED Carl F. Rose DATE 10-27-71
REGISTERED LAND SURVEYOR 12020

DISTRIBUTION:

County Courthouse
Area Forester (Regions I & II)
District or Region Surveyor
Forestry Div., Lansing

R 4047
Rev. 10/68