

STATE OF MICHIGAN  
DEPARTMENT  
OF  
NATURAL RESOURCES

LAND CORNER RECORD


ANTRIM COUNTY  
T 31 N R 5 W

DESCRIPTION OF CORNER E 1/4 corner, Section 1

CORNER MONUMENT Set DNR Monument

DATE MONUMENT PLACED AND WITNESSED 10-20-71

WITNESSES TO CORNER..... 4" Maple N 81 W 18.0'

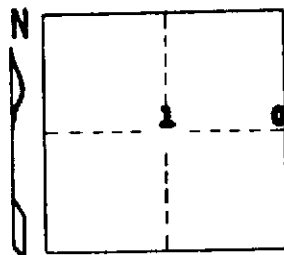

6" Maple West 19.1'


9" Y. Birch S 37 E 41.3'

AND N-S Random Due E 20.5'

CIRCLE CORNER REGISTERED

DESCRIPTION IN DETAIL AS TO HOW CORNER WAS LOCATED AND IDENTIFIED OR RESTORED.

**Corner reestablished per standard BLM instructions.**

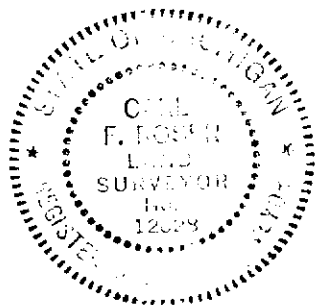

SURVEYOR'S SEAL

SIGNED Carl F. Rose DATE 10-27-71  
REGISTERED LAND SURVEYOR 12028

DISTRIBUTION:

County Courthouse  
Area Forester (Regions I & II)  
District or Region Surveyor  
Forestry Div., Lansing

R 4047  
Rev. 10/68