

✓

STATE OF MICHIGAN
DEPARTMENT
OF
NATURAL RESOURCES

LAND CORNER RECORD


ANTRIM COUNTY
T 31 N R 5 W

DESCRIPTION OF CORNER N 1/4 corner, Section 1

CORNER MONUMENT Set DNR Monument

DATE MONUMENT PLACED AND WITNESSED 10-21-71

WITNESSES TO CORNER..... 5" Twin Maple S 72 E 18.1'

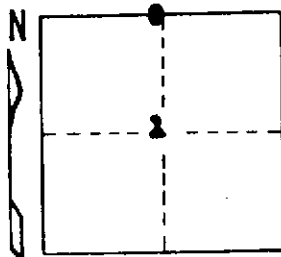

7" Twin Maple S 82 W 10.4'


10" Twin Maple N 7 W 31.9'

AND E-W Random Due N 17.6'

CIRCLE CORNER REGISTERED

DESCRIPTION IN DETAIL AS TO HOW CORNER WAS LOCATED AND IDENTIFIED OR RESTORED.

Corner reestablished per standard BLM instructions.

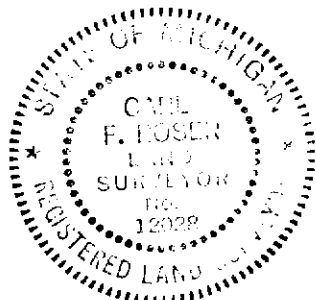

SURVEYOR'S SEAL

SIGNED Carl F. Rosen DATE 10-28-71
REGISTERED LAND SURVEYOR 12028

DISTRIBUTION:

County Courthouse
Area Forester (Regions I & II)
District or Region Surveyor
Forestry Div., Lansing

R 4047
Rev. 10/68