


STATE OF MICHIGAN
DEPARTMENT
OF
NATURAL RESOURCES

LAND CORNER RECORD

ANTRIM COUNTY
T 31 N R 5 W

DESCRIPTION OF CORNER E 1/16 corner on N. line of Sec. 1.
CORNER MONUMENT Set 1"x28" pipe
DATE MONUMENT PLACED AND WITNESSED 10-21-71
WITNESSES TO CORNER.....

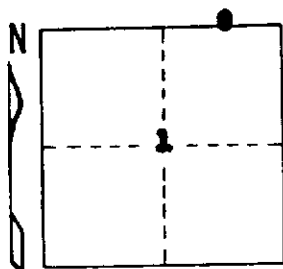


6" Maple S 89 E 29.1'
5" Maple N 85 W 27.5'
AND
E-W Random Due N 28.5'

CIRCLE CORNER REGISTERED

DESCRIPTION IN DETAIL AS TO HOW CORNER WAS LOCATED AND IDENTIFIED OR RESTORED.

Corner established per standard M.L.S. instructions.

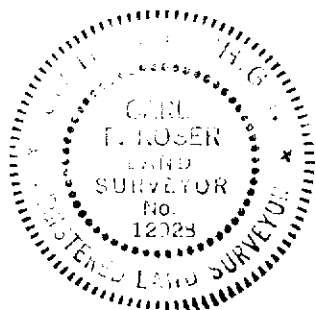

SURVEYOR'S SEAL

SIGNED Carl F. Rosen DATE 10-28-71
REGISTERED LAND SURVEYOR 12028

DISTRIBUTION:

County Courthouse
Area Forester (Regions I & II)
District or Region Surveyor
Forestry Div., Lansing

R 4047
Rev. 10/68