


STATE OF MICHIGAN
DEPARTMENT
OF
NATURAL RESOURCES

LAND CORNER RECORD

ANTHUR COUNTY
T 31 N R 5 W

DESCRIPTION OF CORNER S 1/4 corner, Section 14
CORNER MONUMENT Set 1"x36" pipe
DATE MONUMENT PLACED AND WITNESSED 10-15-71
WITNESSES TO CORNER..... P. Pole N 82 E 115.12'

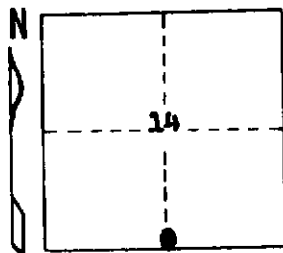


P. Pole N 73 W 1 117.70'
8" Maple S 9 W 72.00'
AND
Ctr. E-W County Road Due S. 2.5'

CIRCLE CORNER REGISTERED

DESCRIPTION IN DETAIL AS TO HOW CORNER WAS LOCATED AND IDENTIFIED OR RESTORED.

Corner reestablished per standard M&M instructions, which is in line with fence to N and S.

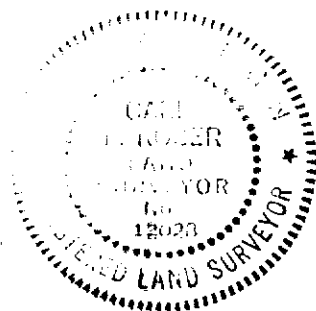

SURVEYOR'S SEAL

Carl F. Roser

SIGNED REGISTERED LAND SURVEYOR

DATE 10-22-71

DISTRIBUTION:

County Courthouse
Area Forester (Regions I & II)
District or Region Surveyor
Forestry Div., Lansing

R 4047
Rev. 10/68