

STATE OF MICHIGAN
DEPARTMENT
OF
NATURAL RESOURCES
LAND CORNER RECORD


ANTRIM COUNTY
T 31 N R 5 W

DESCRIPTION OF CORNER W 1/4 corner of Section 14

CORNER MONUMENT Found 1" pipe

DATE MONUMENT PLACED AND WITNESSED 10-14-71

WITNESSES TO CORNER..... 8" Maple, triple N 50 E 38.6'

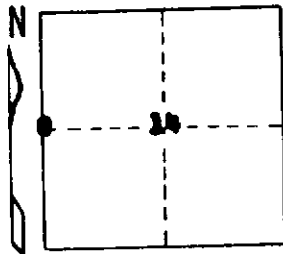

8" Maple N 52 W 41.3'

P. Pole S 8 W 88.00'


AND

Corner in Ctr old N-S Road.

CIRCLE CORNER REGISTERED

DESCRIPTION IN DETAIL AS TO HOW CORNER WAS LOCATED AND IDENTIFIED OR RESTORED.

Found 1" Pipe as established by N.S.H.D. in 1962.

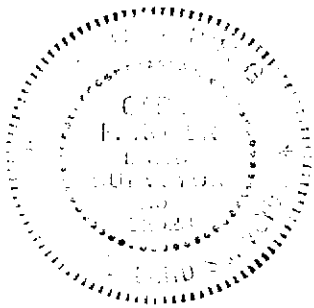

SURVEYOR'S SEAL

SIGNED Carl F. Rorer DATE 10-21-71
REGISTERED LAND SURVEYOR 12028

DISTRIBUTION:

County Courthouse
Area Forester (Regions I & II)
District or Region Surveyor
Forestry Div., Lansing

R 4047
Rev. 10/68