


STATE OF MICHIGAN
DEPARTMENT
OF
NATURAL RESOURCES

LAND CORNER RECORD

ANTRIM COUNTY
T 81 N R 5 W

DESCRIPTION OF CORNER SE corner, Section 14
CORNER MONUMENT Found 1 1/2" pipe
DATE MONUMENT PLACED AND WITNESSED 10-15-71
WITNESSES TO CORNER.....

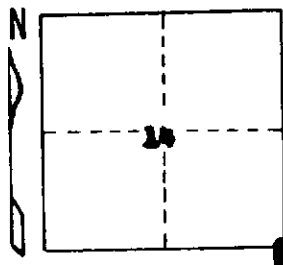


20" Basswood N 59 W 65.63'
P. Pole N 68 E 41.00'
AND

CIRCLE CORNER REGISTERED

DESCRIPTION IN DETAIL AS TO HOW CORNER WAS LOCATED AND IDENTIFIED OR RESTORED.

Found 1 1/2" pipe in approximately road intersection N-S-E-W. Corner fits M.S.H.D. tie in 1948.

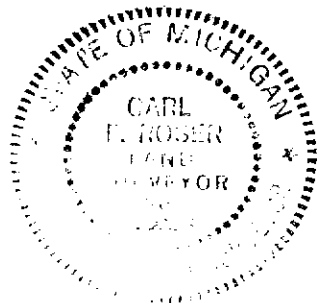

SURVEYOR'S SEAL

SIGNED Carl F. Rover DATE 10-22-71
REGISTERED LAND SURVEYOR 12028

DISTRIBUTION:

County Courthouse
Area Forester (Regions I & II)
District or Region Surveyor
Forestry Div., Lansing

R 4047
Rev. 10/68