


STATE OF MICHIGAN
DEPARTMENT
OF
NATURAL RESOURCES

LAND CORNER RECORD

ANTRIM COUNTY
T 21 N R 5 W

DESCRIPTION OF CORNER NE corner, Section 12
CORNER MONUMENT Set DNR Monument & Cedar Guard Post
DATE MONUMENT PLACED AND WITNESSED 10-15-71
WITNESSES TO CORNER..... 6" Maple N 33 E 16.4'

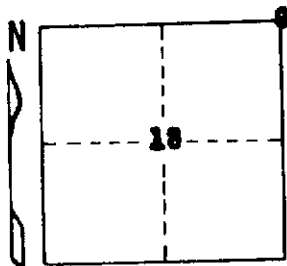


12" Maple N 55 W 70.5'
4" Conc. Mon. S 47 W 48.00'
AND
Old Pa. W. Due S. 7'

CIRCLE CORNER REGISTERED

DESCRIPTION IN DETAIL AS TO HOW CORNER WAS LOCATED AND IDENTIFIED OR RESTORED.

Restored DeLaMater corner per his survey of record at Otsego County Register of Deeds,
L.S. P. 330, dated 1925 to 1938.

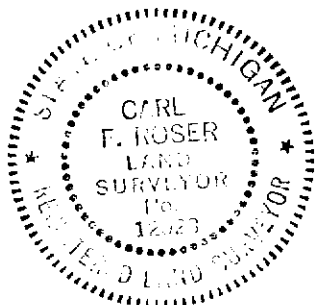

SURVEYOR'S SEAL

SIGNED Carl F. Roser DATE 10-22-71
REGISTERED LAND SURVEYOR 12023

DISTRIBUTION:

County Courthouse
Area Forester (Regions I & II)
District or Region Surveyor
Forestry Div., Lansing

R 4047
Rev. 10/68