


STATE OF MICHIGAN  
DEPARTMENT  
OF  
NATURAL RESOURCES

LAND CORNER RECORD

ANTRIM COUNTY  
T 21 N R 5 W


DESCRIPTION OF CORNER NE corner, Section 12  
CORNER MONUMENT Set BNR Monument  
DATE MONUMENT PLACED AND WITNESSED 9-24-71  
WITNESSES TO CORNER..... 7" Maple N 05 E 8.3'  
5" Maple N 43 E 37.6'  
14" Maple N 67 E 42.6'  
AND  
N-S Random Due E 10'

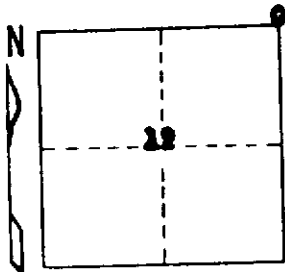

CIRCLE CORNER REGISTERED

DESCRIPTION IN DETAIL AS TO HOW CORNER WAS LOCATED AND IDENTIFIED OR RESTORED.

Corner reestablished per standard BLM instructions.

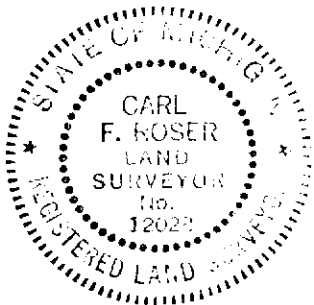

SURVEYOR'S SEAL

SIGNED Carl F. Roser DATE 10-1-71  
REGISTERED LAND SURVEYOR 12028

DISTRIBUTION:

County Courthouse  
Area Forester (Regions I & II)  
District or Region Surveyor  
Forestry Div., Lansing

R 4047  
Rev. 10/68