


STATE OF MICHIGAN
DEPARTMENT
OF
NATURAL RESOURCES

LAND CORNER RECORD

ANTRIM COUNTY
T 31 N R 5 W

DESCRIPTION OF CORNER E 1/4 corner, Section 12
CORNER MONUMENT Set DMR Monument
DATE MONUMENT PLACED AND WITNESSED 10-15-71
WITNESSES TO CORNER..... 10" B. Cherry S 33 W 45.0'

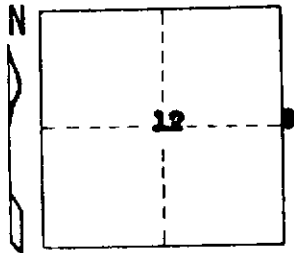


9" B. Cherry S 35 E 49.2'
9" B. Cherry N 62 E 27.0'
AND
N-S Trail Rd. Due E 150'

CIRCLE CORNER REGISTERED

DESCRIPTION IN DETAIL AS TO HOW CORNER WAS LOCATED AND IDENTIFIED OR RESTORED.

Corner reestablished per standard BM instructions.

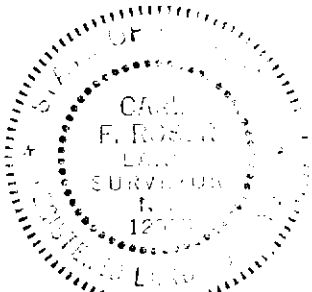

SURVEYOR'S SEAL

SIGNED Carl F. Roser DATE 10-22-71
REGISTERED LAND SURVEYOR 12020

DISTRIBUTION:

County Courthouse
Area Forester (Regions I & II)
District or Region Surveyor
Forestry Div., Lansing

R 4047
Rev. 10/68