

STATE OF MICHIGAN
DEPARTMENT
OF
NATURAL RESOURCES

LAND CORNER RECORD


ANTRIM COUNTY
T 31 N R 5 W

DESCRIPTION OF CORNER 1/4 Corner, Section 11

CORNER MONUMENT Set DNR Monument

DATE MONUMENT PLACED AND WITNESSED 10-14-71

WITNESSES TO CORNER.....	<u>6" Apple</u>	<u>S 42 E</u>	<u>7.3'</u>
	<u>5" Maple</u>	<u>N 28 E</u>	<u>32.1'</u>
	<u>12" Y. Birch (growing in white pine stp.)</u>	<u>N 82 W</u>	<u>45.5'</u>
	<u>AND Ctr. N-S Conc. Pav't US-131</u>	<u>Due E</u>	<u>89.3'</u>

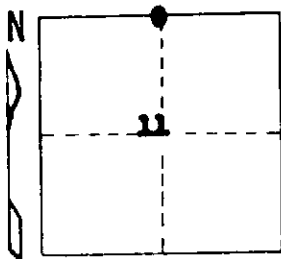


CIRCLE CORNER REGISTERED

DESCRIPTION IN DETAIL AS TO HOW CORNER WAS LOCATED AND IDENTIFIED OR RESTORED.

Corner reestablished per standard BLM instructions, equidistant and on line between section corners E & W. The corner positioned by this method fits U.S. tie West to Spring and East to Stream. The M.S.H.D. in 1946 showed a tie for E.O.W. acquisition as follows: "1/4 corner is 24" Hemlock stump identified by local residents as being of the tree that was used as corner by lumbermen". The MSHD did not set a physical monument. U.S. notes call for a set post for 1/4 corner, not a tree, MSHD position for corner would be about 36' East and 70' South of proper 1/4 corner, which in no way would fit U.S. tie to Spring W and Stream E.

MSHD position for 1/4 corner therefore was disregarded. Ctr old N-W-SE R.R. Grade Due W. 86.5'.

SURVEYOR'S SEAL

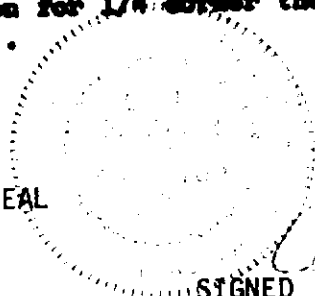

SIGNED

Carl F. Roser

DATE

10-21-71

DISTRIBUTION:

REGISTERED LAND SURVEYOR

12020

County Courthouse
Area Forester (Regions I & II)
District or Region Surveyor
Forestry Div., Lansing

R 4047
Rev. 10/68