


STATE OF MICHIGAN
DEPARTMENT
OF
NATURAL RESOURCES

LAND CORNER RECORD

ANTRIM COUNTY
T 31 N R 5 W

DESCRIPTION OF CORNER E 1/16 corner on E-W 1/4 line, Sec. 11
CORNER MONUMENT Set 1"x36" pipe & location tag
DATE MONUMENT PLACED AND WITNESSED 10-14-71
WITNESSES TO CORNER..... 5" Maple twin N 70 W 10.9'

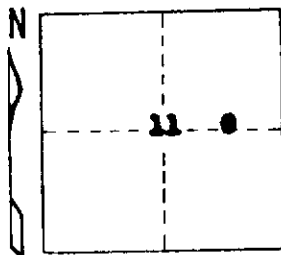


14" Ash S 59 E 11.6'
12" Maple S 17 W 41.1'
AND
Ctr. N-S Co. Rd. Due W 116'

CIRCLE CORNER REGISTERED

DESCRIPTION IN DETAIL AS TO HOW CORNER WAS LOCATED AND IDENTIFIED OR RESTORED.

Corner established per standard BLM instructions.

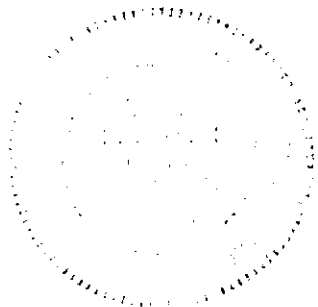

SURVEYOR'S SEAL

SIGNED *Robert F. Hoover* DATE 10-21-71
REGISTERED LAND SURVEYOR 12028

DISTRIBUTION:

County Courthouse
Area Forester (Regions I & II)
District or Region Surveyor
Forestry Div., Lansing