


STATE OF MICHIGAN
DEPARTMENT
OF
NATURAL RESOURCES

LAND CORNER RECORD

ANTRIM COUNTY
T 31 N R 5 W

DESCRIPTION OF CORNER Ctr. of Sec. 11
CORNER MONUMENT Set 1"x36" pipe
DATE MONUMENT PLACED AND WITNESSED 10-27-71
WITNESSES TO CORNER..... 14" Beech S 45 W 5.8'

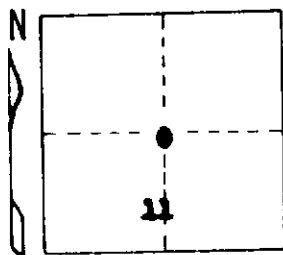


20" Beech N 87 W 16.1'
16" Y. Birch N 4 W 47.7'
AND
Ctr. US-181 Pavt. Due E 87.9'

CIRCLE CORNER REGISTERED

DESCRIPTION IN DETAIL AS TO HOW CORNER WAS LOCATED AND IDENTIFIED OR RESTORED.

Corner established per standard BLM instructions.

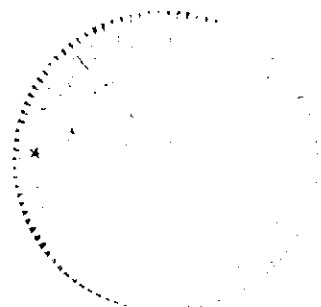

SURVEYOR'S SEAL

SIGNED

Carl F. Roser

DATE

11-8-71

DISTRIBUTION:

REGISTERED LAND SURVEYOR 12028

County Courthouse
Area Forester (Regions I & II)
District or Region Surveyor
Forestry Div., Lansing

R 4047
Rev. 10/68