


STATE OF MICHIGAN
DEPARTMENT
OF
NATURAL RESOURCES

LAND CORNER RECORD

ANTRIM COUNTY
T 31 N R 5 W


DESCRIPTION OF CORNER N 1/16 corner on N-S 1/4 line, Sec. 11
CORNER MONUMENT Set 1"x36" pipe
DATE MONUMENT PLACED AND WITNESSED 10-27-71
WITNESSES TO CORNER..... 14" Hemlock N 65 W 79.1'

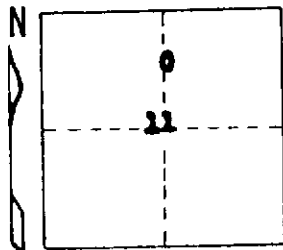

14" Hemlock N 4 W 126.6'
7" Maple Due S 100.0'
AND
Ctr. US-131 Pavt. Due E 88.6'

CIRCLE CORNER REGISTERED

DESCRIPTION IN DETAIL AS TO HOW CORNER WAS LOCATED AND IDENTIFIED OR RESTORED.
Corner established per standard BLM instructions.

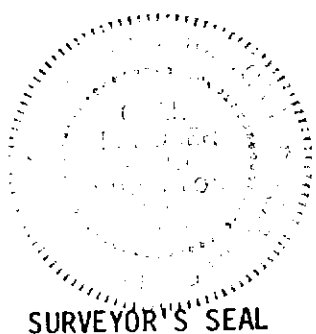

SURVEYOR'S SEAL

SIGNED *Bill F. Roser* DATE 11-3-71
REGISTERED LAND SURVEYOR 12028

DISTRIBUTION:

County Courthouse
Area Forester (Regions I & II)
District or Region Surveyor
Forestry Div., Lansing

R 4047
Rev. 10/68