


STATE OF MICHIGAN
DEPARTMENT
OF
NATURAL RESOURCES

LAND CORNER RECORD

ANTRIM COUNTY
T 31 N R 5 W

DESCRIPTION OF CORNER W 1/4 corner, Section 11
CORNER MONUMENT Set DNR monument
DATE MONUMENT PLACED AND WITNESSED 10-18-71
WITNESSES TO CORNER..... 6" Ironwood N 47 W 35.1'

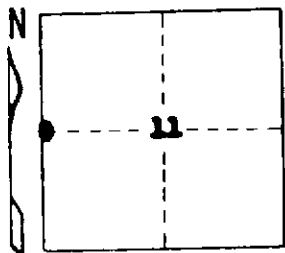


10" Maple S 37 W 12.0'
10" Maple S 60 E 36.8'
AND
N-S Random Due W 1.1'

CIRCLE CORNER REGISTERED

DESCRIPTION IN DETAIL AS TO HOW CORNER WAS LOCATED AND IDENTIFIED OR RESTORED.

Corner reestablished per standard BLM instructions.

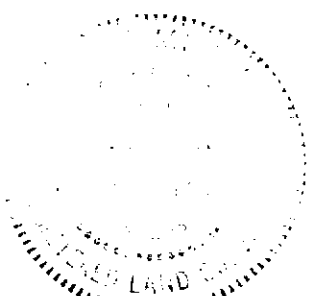

SURVEYOR'S SEAL

SIGNED

Carl F. Raser

DATE

10-25-71

REGISTERED LAND SURVEYOR 12028

DISTRIBUTION:

County Courthouse
Area Forester (Regions I & II)
District or Region Surveyor
Forestry Div., Lansing

R 4047
Rev. 10/68