

STATE OF MICHIGAN
DEPARTMENT
OF
NATURAL RESOURCES

LAND CORNER RECORD


ANTRIM COUNTY
T 31 N R 5 W

DESCRIPTION OF CORNER E 1/4 corner, Section 11

CORNER MONUMENT Set DNR Monument

DATE MONUMENT PLACED AND WITNESSED 10-22-71

WITNESSES TO CORNER..... 4" Maple S 62 E 5.9'

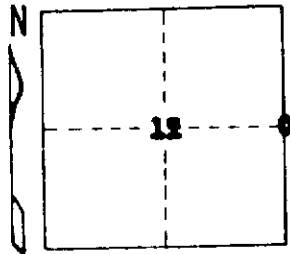

6" Y. Birch N 31 E 13.9'


7" Maple S 58 W 55.0'

AND
N-S Random Due W 1.94'

CIRCLE CORNER REGISTERED

DESCRIPTION IN DETAIL AS TO HOW CORNER WAS LOCATED AND IDENTIFIED OR RESTORED.

Corner reestablished per Std. BLN instructions.

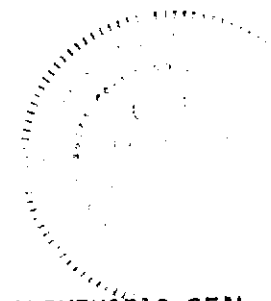

SURVEYOR'S SEAL

SIGNED *W. F. Rorer* DATE 10-29-71
REGISTERED LAND SURVEYOR 12028

DISTRIBUTION:

County Courthouse
Area Forester (Regions I & II)
District or Region Surveyor
Forestry Div., Lansing

R 4047
Rev. 10/68