

STATE OF MICHIGAN  
DEPARTMENT  
OF  
NATURAL RESOURCES

LAND CORNER RECORD


ANTRIM COUNTY  
T 31 N R 5- W

DESCRIPTION OF CORNER SE Cor. of Sec. 11

CORNER MONUMENT Set DNR Mon & Cedar Post by old cor. fence post.

DATE MONUMENT PLACED AND WITNESSED 9-10-71

WITNESSES TO CORNER..... 8" Maple S 52 E 55.3'

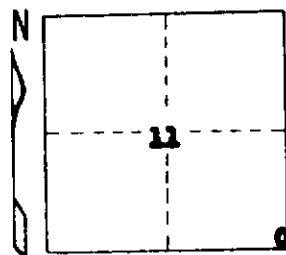

12" Cedar N 45 E 65.0'

10" Maple S 45 W 24.8'

AND


8" Maple S 85 W 19.9'

Random N Due W 3.6'

CIRCLE CORNER REGISTERED

DESCRIPTION IN DETAIL AS TO HOW CORNER WAS LOCATED AND IDENTIFIED OR RESTORED.

**Found old corner fence post in swamp with fence remains N. S. & E. Fence corner fits US tie to Spring Brook, 3 links, 354 ft. East and run, 2 links, 116' East.**

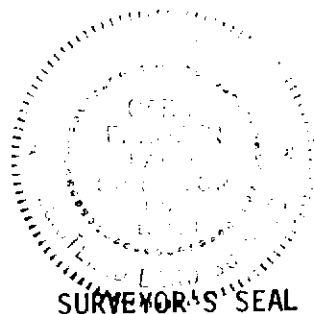

SIGNED *[Signature]* DATE 9-17-71  
REGISTERED LAND SURVEYOR 12028

DISTRIBUTION:

County Courthouse  
Area Forester (Regions I & II)  
District or Region Surveyor  
Forestry Div., Lansing

R 4047  
Rev. 10/68