


STATE OF MICHIGAN
DEPARTMENT
OF
NATURAL RESOURCES

LAND CORNER RECORD

ANTRIM COUNTY
T 31 N R 5 W

DESCRIPTION OF CORNER E 1/16 cor. on N Line of Sec. 11
CORNER MONUMENT Set 1"x30" Pipe
DATE MONUMENT PLACED AND WITNESSED 10-14-71
WITNESSES TO CORNER..... 12" Cedar N 88 W 16.1'

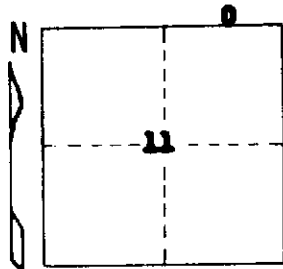


6" Cedar S 19 W 21.0'
4" Cedar N 38 E 13.4'
AND Ctr N-S Co. Rd. Due W 155'
N-S Fn. remains Due W 16'
E-W Fn. remains (on skew) Due N 34'

CIRCLE CORNER REGISTERED

DESCRIPTION IN DETAIL AS TO HOW CORNER WAS LOCATED AND IDENTIFIED OR RESTORED.

Corner established per Std. BLM instructions. Also see restoration procedure B. for $\frac{1}{16}$ Cor. Sec. 11 (J-3) and SE Corner of Sec. 2 (K-3). A fairly new 1/2" pipe at old corner since post is 30.6' North and 16.8' West. An old fence runs N88°00'E from the corner post where it intersects the end and ends at Westerly R.R. ROW fence, on curve. I inquired, as to when and why this fence was constructed, of Mrs. Lick (estimated age in her 80s - daughter's name, Mrs. Szczepaniak) who used to own the Ne-Ne of Sec. 11, and was advised that the fence along their N line had been built about 1915-1920 by her husband (deceased). They definitely did not hire a surveyor to locate the line, and the fence had been put up to keep cattle in.

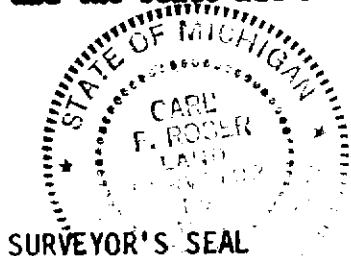

SURVEYOR'S SEAL

SIGNED Carl F. Rose DATE 10-21-71
REGISTERED LAND SURVEYOR 12028

DISTRIBUTION:

County Courthouse
Area Forester (Regions I & II)
District or Region Surveyor
Forestry Div., Lansing

R 4047
Rev. 10/68