

STATE OF MICHIGAN
DEPARTMENT
OF
NATURAL RESOURCES

LAND CORNER RECORD


ANTRIM COUNTY
T 31 N R 5 W

DESCRIPTION OF CORNER NW Corner of Sec. 10

CORNER MONUMENT Set DNR Monument

DATE MONUMENT PLACED AND WITNESSED 10-26-71

WITNESSES TO CORNER..... 6" Maple S 50 E 24.7'

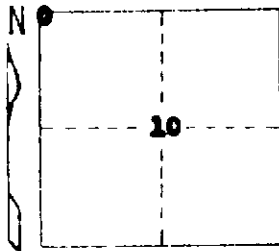

10" Maple N 80 W 37.0'

14" Hemlock N 50 E 118.3'

AND N-S Fm. Remains Due W 20' ±


E-W Trail Rd. Due N. 93'

CIRCLE CORNER REGISTERED

N-S Random Due W. 1.2'

DESCRIPTION IN DETAIL AS TO HOW CORNER WAS LOCATED AND IDENTIFIED OR RESTORED.

Reestablished corner on straight line and proportionate distance between section corners 1 mile N & S. U.S. ran North three miles straight line from the center of the Twp.

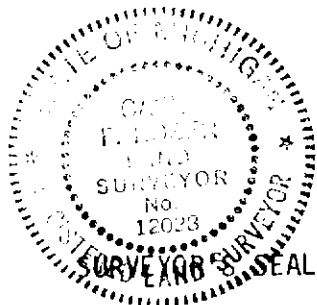

SIGNED Carl F. Rover DATE 11-4-71
REGISTERED LAND SURVEYOR 12028

DISTRIBUTION:

County Courthouse
Area Forester (Regions I & II)
District or Region Surveyor
Forestry Div., Lansing

R 4047
Rev. 10/68