

STATE OF MICHIGAN
DEPARTMENT
OF
NATURAL RESOURCES

LAND CORNER RECORD

ANTRIM

COUNTY


T 31 N R 5 W

DESCRIPTION OF CORNER W 1/4 Corner of Sec. 10

CORNER MONUMENT Set DNR Monument

DATE MONUMENT PLACED AND WITNESSED 10-26-71

WITNESSES TO CORNER..... 10" Ironwood S 57 W 27.5'

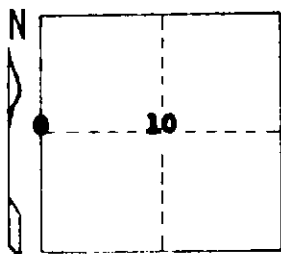

12" Maple N 47 W 89.7'

9" Maple N 4 E 34.9'


AND

N-S Random Due W. 1.8'

CIRCLE CORNER REGISTERED

DESCRIPTION IN DETAIL AS TO HOW CORNER WAS LOCATED AND IDENTIFIED OR RESTORED.

Corner reestablished per standard BLN instructions.

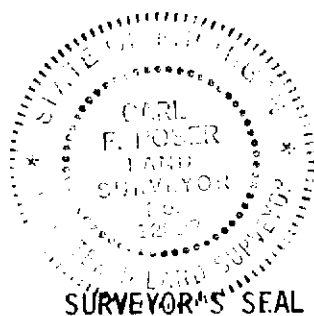

SURVEYOR'S SEAL

SIGNED

Carl F. Rose

REGISTERED LAND SURVEYOR

DATE 11-4-71

DISTRIBUTION:

County Courthouse
Area Forester (Regions I & II)
District or Region Surveyor
Forestry Div., Lansing

12028