

STATE OF MICHIGAN  
DEPARTMENT  
OF  
NATURAL RESOURCES

LAND CORNER RECORD

ANTRIM ~~EMMET~~ COUNTY


T 21 N R 5 W

DESCRIPTION OF CORNER E 1/16 corner on N. line Sec. 6

CORNER MONUMENT Set 1" x 26" pipe

DATE MONUMENT PLACED AND WITNESSED 11-19-71

WITNESSES TO CORNER..... 10" Maple N 59 E 20.8'

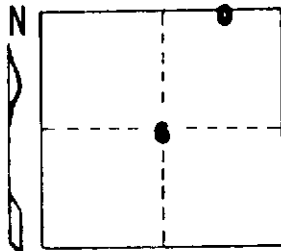

11" Beech S 50 E 20.5'


9" Maple S 46 W 20.6'

AND  
E-W Random Due S 6'

CIRCLE CORNER REGISTERED

DESCRIPTION IN DETAIL AS TO HOW CORNER WAS LOCATED AND IDENTIFIED OR RESTORED.

**Corner established per standard BLM instructions.**

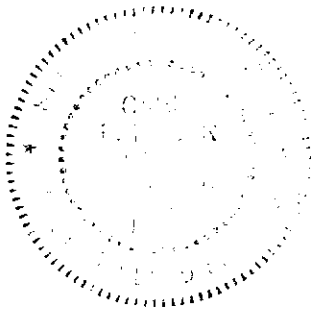

SURVEYOR'S SEAL

SIGNED

*Carl F. Roser*

DATE

11-26-71

DISTRIBUTION:

REGISTERED LAND SURVEYOR **12028**

County Courthouse  
Area Forester (Regions I & II)  
District or Region Surveyor  
Forestry Div., Lansing

R 4047  
Rev. 10/68