

STATE OF MICHIGAN
DEPARTMENT
OF
NATURAL RESOURCES

LAND CORNER RECORD


ANTRIM COUNTY
T 31 N R 5 W

DESCRIPTION OF CORNER N 1/4 corner Sec. 6

CORNER MONUMENT Set DNR Mon. at fence corner

DATE MONUMENT PLACED AND WITNESSED 11-22-71

WITNESSES TO CORNER..... 9" Maple S 15 W 27.5'

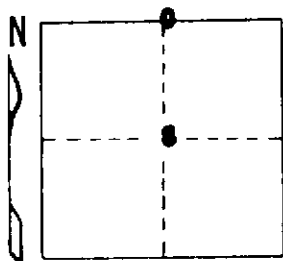

6" Ironwood twin S 54 W 29.0'


10" Maple N 30 E 37.4'

AND

CIRCLE CORNER REGISTERED

DESCRIPTION IN DETAIL AS TO HOW CORNER WAS LOCATED AND IDENTIFIED OR RESTORED.

Corner restored at corner fence post, very old fence remains N-S-W. Corner falls part way down Easterly slope of very steep hill. U.S. 'calls' to stream crossing to East are in error by some four chains. The 1/4 corner (fence corner) fits a position by single proportion very closely.

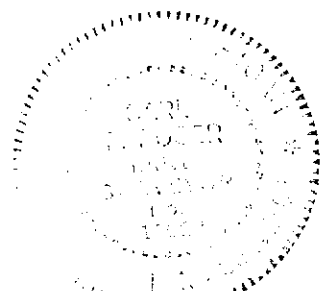

SURVEYOR'S SEAL

SIGNED

A. Rover
REGISTERED LAND SURVEYOR 12028

DATE

11-29-71

DISTRIBUTION:

County Courthouse
Area Forester (Regions I & II)
District or Region Surveyor
Forestry Div., Lansing

R 4047
Rev. 10/68