

STATE OF MICHIGAN
DEPARTMENT
OF
NATURAL RESOURCES

LAND CORNER RECORD


ANTRIM COUNTY

DESCRIPTION OF CORNER N 1/4 corner Section 5

CORNER MONUMENT Set DNR Monument

DATE MONUMENT PLACED AND WITNESSED 11-19-71

WITNESSES TO CORNER..... 8" Maple S 82 W 18.7'

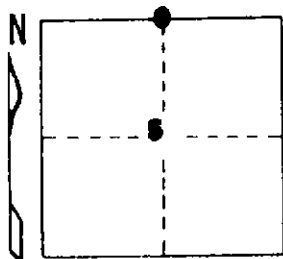

9" Maple S 14 E 10.7'


10" Maple N 25 W 27.5'

AND E-W Random Due S 26'

CIRCLE CORNER REGISTERED

DESCRIPTION IN DETAIL AS TO HOW CORNER WAS LOCATED AND IDENTIFIED OR RESTORED.

Corner reestablished per standard B.L.M. instructions.

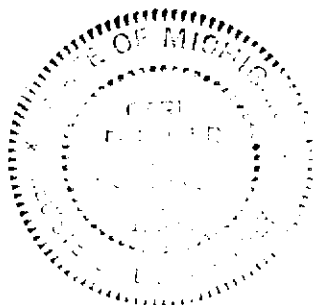

SURVEYOR'S SEAL

SIGNED Paul F. Roser DATE 11-26-71
REGISTERED LAND SURVEYOR **12028**

DISTRIBUTION:

County Courthouse
Area Forester (Regions I & II)
District or Region Surveyor
Forestry Div., Lansing

R 4047
Rev. 10/68