

STATE OF MICHIGAN  
DEPARTMENT  
OF  
NATURAL RESOURCES

LAND CORNER RECORD


ANTRIM COUNTY  
T 31 N R 5 W

DESCRIPTION OF CORNER SW Sec. Corner, Sec. 5

CORNER MONUMENT Set DNR Monument by corner fence post

DATE MONUMENT PLACED AND WITNESSED 11-10-71

WITNESSES TO CORNER..... 18" Elm S 2 E 40.80'

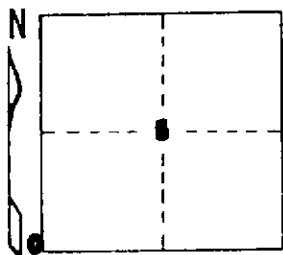

P. Pole N 32 E 42.60'

12" Maple S 59 E 90.32'


AND

Ctr. of Rd on curve N 45 E 86'

CIRCLE CORNER REGISTERED

DESCRIPTION IN DETAIL AS TO HOW CORNER WAS LOCATED AND IDENTIFIED OR RESTORED.

Corner restored by corner fence post, fence West & South, and in line with Ctr. of Rd. to North & East.

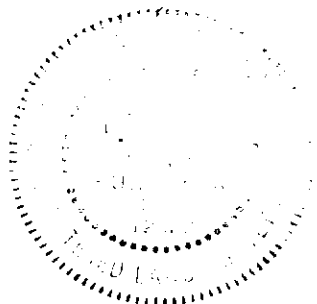

SURVEYOR'S SEAL

SIGNED

*Carl F. Rorer*

DATE

11-17-71

DISTRIBUTION:

REGISTERED LAND SURVEYOR **12028**

County Courthouse  
Area Forester (Regions I & II)  
District or Region Surveyor  
Forestry Div., Lansing

R 4047  
Rev. 10/68