

LAND CORNER RECORDATION CERTIFICATE

FILING REQUIREMENT OF ACT 74, MICH. P.A.1970

FOR CORNERS OF--:	LOCATED IN--:	CORNER CODE NUMBER
1. PUBLIC LAND SURVEY _____	T. 31 ^{N.} <input checked="" type="radio"/> R. 6 ^{W.} <input checked="" type="radio"/>	F-13; G-13
2. PROPERTY CONTROLLING IN SECTION 33 _____	T. 31 ^{N.} <input checked="" type="radio"/> R. 6 ^{W.} <input checked="" type="radio"/>	15
3. MISCELLANEOUS PROPERTY IN SECTION _____	T. _____ ^{N.} <input type="radio"/> R. _____ ^{E.} <input type="radio"/>	_____
4. LOT NO. _____, RECORDED PLAT _____		
5. PRIVATE CLAIMS _____		

REGISTER OF DEEDS STAMP AND FILING NUMBER

I, Carl F. Roser, do hereby certify that under requirements of P.A. 74, Michigan P.A. of 1970, the corner points mentioned in lines 1 and 2 above were, in a field survey on April 8, 1974, established, re-established, monumented, re-monumented, recovered or restored as expressed below and in conformance with regulations and rules therefore as required in the current manual of survey instructions of the United States Department of the Interior, Bureau of Land Management or by a decree of a court of law. Furthermore, that the corner points mentioned in lines 3, 4 and 5 above were, in a field survey on _____, 19____, found, recovered, restored, established or re-established as expressed below and in conformance with the rules of the Michigan State Board of Registration for Land Surveyors or, by a Decree of a Court of law:

A. Description of original monument and accessories and/or subsequent restoration:

B. Description of corner evidence found and/or method applied in restoring or re-establishing corner:


- F-13 Reestablished 1/4 corner on third correction line equidistant and on line between SE & SW of Sec. 33 T31N-R6W, these section corners being recovered corners in 1962 dept. survey. The section corner on third correction line common to Sec's 4 & 5 T30N-R6W is S89°48'30"E, 331.86'.
- G-13 Found dept. monument from previous dept. survey. Corner was found in 1962 as a RR iron on end with dept. monument added in 1962.
- 15 Established west 1/8 corner on third correction line equidistant and on line between the SW and S1/4 corners of Sec. 33, T31N-R6W.

C. Description of monument for corner and accessories established to perpetuate locating the position of the corner:

F-13	G-13	15
Set DNR mon. & cedar post	Found DNR mon. & set Cedar post	Set 1"x36" pipe & cedar post w/loc. tag
6" Maple S52°W 51.7	12" Maple N07°E 27.3	10" Maple S58°W 24.9
9" Maple N45°W 19.5	8" Maple N84°W 16.2	5" Maple S03°E 30.2
5" Maple N03°E 38.6	9" Maple S47°W 15.2	4" Ironwood S47°E 9.1
on E-W Random Line	7" Maple S24°E 12.6	on E-W Random Line

SIGNED BY Carl F. Roser 9-15-76 DATE _____

SURVEYOR'S MICHIGAN REGISTRATION NO. 12028

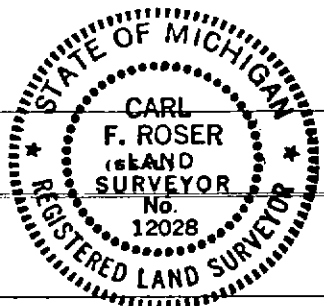

FOR STATE AND UNITED STATES AGENCIES:

SIGNED BY _____ DATE _____
CHIEF OF SURVEY PARTY

APPROVED AND SIGNED BY _____ DATE _____
MICHIGAN REGISTERED LAND SURVEYOR

(SEAL)

SURVEYOR'S MICHIGAN REGISTRATION NO. _____ JORDAN TOWNSHIP ANTRIM COUNTY