

# LAND CORNER RECORDATION CERTIFICATE

Filing Requirement of Act 74, Mich. PA 1970

For Corners In:  
 Antrim \_\_\_\_\_ Located In \_\_\_\_\_ Corner Code # \_\_\_\_\_  
 (County)


1. Public Land Survey	T _____	R _____		
	T _____	R _____		
2. Property Controlling in Section	S <u>29</u>	T <u>31N</u>	R <u>6W</u>	<u>15</u>
	S <u>29</u>	T <u>31N</u>	R <u>6w</u>	<u>8</u>
3. Miscellaneous Property in Section	S _____	T _____	R _____	
	S _____	T _____	R _____	

4. Lot No: \_\_\_\_\_ Recorded Plat: \_\_\_\_\_  
 5. Private Claims: \_\_\_\_\_

I, Carl T. Kiiskila, in a field survey on August 7, 2002 do hereby state that under requirements of PA 74, Michigan PA of 1970, the corner points mentioned in lines 1 and 2 above were in conformance with regulations and rules therefore as required in the current manual of survey instructions of the United States Department of the Interior, Bureau of Land Management or by a decree of a Court of Law and/or that the corner points mentioned in lines 3, 4 and 5 above were in conformance with the rules of the Michigan Board of Land Surveyors or by a Decree of a Court of Law, established, re-established, monumented, recovered, found as expressed below:

**NOTE: Not more than 2 corners, all in the same town and range, may be recorded on this certificate.**

Register of Deeds Stamp & File Number

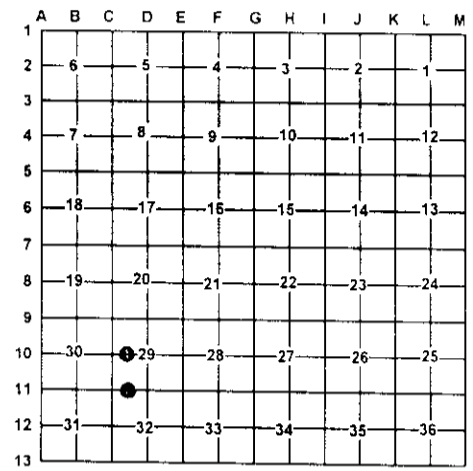

A. Description of original monument and accessories and/or subsequent restoration:

15- This corner position was not established during the original government survey.	8- This corner position was not established during the original government survey.
---	--

B. Description of corner evidence found and/or method applies in restoring or re-establishing corner:

15- Established the Southwest corner of the southeast quarter of the southwest quarter of section 29 per B.L.M. instructions for the subdivision of a section.	8- Established the Northwest corner of the Northeast quarter of the Southwest quarter of section 29 per B.L.M. instructions for the subdivision of a section.
--	---

C. Description of monument for corner and accessories established to perpetuate locating the position of the corner:

15- Set a 5/8" X 32" rerod with P.S. cap #33981 Wit: 10" W. Pine      S01°W    27.55' 4" Balsam        N72°W    24.28' 14" W. Pine      N46°E    20.15' 9" W. Pine        S44°E    38.60' 1/2" Capped rerod S11°E    1.30' B. Jones #23514	8- Set 1" X 48" pipe with P.S. cap #33981 Wit: 5" Balsam        S89°W    43.43' 14" Maple        N57°E    50.02' 5" Balsam        S87°E    31.99' 8" Maple         S16°w    36.17'
--	--

Signed by: Carl T. Kiiskila  
 Surveyor's Michigan License No.: 33981

Date: 8-29-02

