

# LAND CORNER RECORDATION CERTIFICATE

## FILING REQUIREMENT OF ACT 74, MICH. P.A. 1970

FOR CORNERS OF --:	LOCATED IN --:	CORNER CODE NUMBER
1. PUBLIC LAND SURVEY _____	T. <u>31</u> N. <u>7</u> R. <u>7</u> W. <u>●</u>	M-13
2. PROPERTY CONTROLLING IN SECTION <u>36</u>	T. <u>31</u> N. <u>7</u> R. <u>7</u> W. <u>●</u>	7; 14
3. MISCELLANEOUS PROPERTY IN SECTION _____	T. _____ N. _____ R. _____ W. _____	_____
4. LOT NO. _____, RECORDED PLAT _____		
5. PRIVATE CLAIMS _____		

REGISTER OF DEEDS STAMP AND FILING NUMBER

I, Carl F. Roser, do hereby certify that under requirements of P.A. 74, Michigan P.A. of 1970, the corner points mentioned in lines 1 and 2 above were, in a field survey on April 8, 1974, established, re-established, monumented, re-monumented, recovered or restored as expressed below and in conformance with regulations and rules therefore as required in the current manual of survey instructions of the United States Department of the Interior, Bureau of Land Management or by a decree of a court of law. Furthermore, that the corner points mentioned in lines 3, 4 and 5 above were, in a field survey on \_\_\_\_\_, 19\_\_\_\_, found, recovered, restored, established or re-established as expressed below and in conformance with the rules of the Michigan State Board of Registration for Land Surveyors or, by a Decree of a Court of law:

~~As Description of original monument and accessories and for subsequent restoration:~~

B. (continued)

are long, the stream tie fits reasonable.

- 7 Established 1/16 corner equidistant & on line between section corner to N & 1/2 corner to S.
- 14 Established 1/16 corner equidistant & on line between 1/2 corner to N & section corner to S.

B. Description of corner evidence found and/or method applied in restoring or re-establishing corner:

- 13 Reestablished corner on third correction line, common to T31N-R6W at record G.L.O. distance S (80 chains) from corner common to Sec. 30 & 31, T31N-R6W & Sec. 25 & 36 T31N-R7W & at record G.L.O. distance W (155.30 chains) from corner common to Sec. 32 & 33 on third correction line (T31N-R6W); G.L.O. survey being a U.S. resurvey dated 1856. This method fits very reasonable with Hebden's 1877 dependent resurvey of T30N-R6W & also the G.L.O. resurvey of T30&31N-R7W. Note - the G.L.O. resurvey of T31N-R6W included the resurvey of the third correction line. Corner as reestablished also fits U.S. tie to swamp edge to N (see E 1/2 Sec. 36, M-12) & U.S. tie to stream crossing to W at 29.5 chains (1947'±). We measured 1960'± & since U.S. tie was to nearest 1/2 chain & since the N line & S line of Sec. 36

C. Description of monument for corner and accessories established to perpetuate locating the position of the corner:

M-13	7	14
Set DNR mon. & cedar post	Set 1"x36" pipe & cedar post	Set 1"x36" pipe & cedar post
4" Balsam N47°E 54.3	w/loc. tag	w/loc. tag
9" Balsam N01°E 27.8	9" W. Pine N18°W 50.3	5" Cedar S68°E 11.0
Group of 4 8" Apples	5" Maple S16°W 32.9	5" Cedar Due S 17.2
S86°W 79.4	7" Maple S48°E 34.7	6" Cedar N59°W 21.1
N 1/2 cor. Sec. 1 T30N-R7W	N-S Random Due E 38	5" Cedar N04°E 23.7
N86°18'W 239.05		N-S Random Due E 101.9
Random N Due E 134.5		
Random from E Due S 120.3		

SIGNED BY Carl F. Roser 9-15-76 DATE \_\_\_\_\_

SURVEYOR'S MICHIGAN REGISTRATION NO. 12028


FOR STATE AND UNITED STATES AGENCIES:

SIGNED BY \_\_\_\_\_ DATE \_\_\_\_\_

CHIEF OF SURVEY PARTY

APPROVED AND SIGNED BY \_\_\_\_\_ DATE \_\_\_\_\_

MICHIGAN REGISTERED LAND SURVEYOR

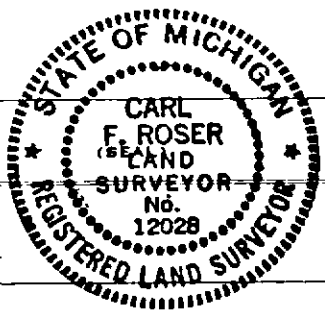

(SEAL)

ECHO TOWNSHIP  
ANTRIM COUNTY

SURVEYOR'S MICHIGAN REGISTRATION NO. \_\_\_\_\_