

**LAND CORNER RECORDATION CERTIFICATE**  
**Filing Requirement of Act 74, Mich. P.A. 1970**

For comers in "ECHO TWP"

Liber **00003** Page **0147**

ANTRIM Located In: \_\_\_\_\_ Corner Code # \_\_\_\_\_  
 (County)

1. Public Land Survey T 31N R 7W E-6  
 T \_\_\_\_\_ R \_\_\_\_\_  
 T \_\_\_\_\_ R \_\_\_\_\_  
 T \_\_\_\_\_ R \_\_\_\_\_

2. Property Controlling S \_\_\_\_\_ T \_\_\_\_\_ R \_\_\_\_\_  
 in Section S \_\_\_\_\_ T \_\_\_\_\_ R \_\_\_\_\_

3. Miscellaneous S \_\_\_\_\_ T \_\_\_\_\_ R \_\_\_\_\_  
 Property in Sec. S \_\_\_\_\_ T \_\_\_\_\_ R \_\_\_\_\_

ANTRIM COUNTY MI.  
 Register of Deeds  
 Recorded

12-21-2000 11:08:33

Wanda R. Conway  
 REGISTER OF DEEDS

**Register of Deeds Stamp & File Number**

4. Lot No. \_\_\_\_\_, Recorded Plat \_\_\_\_\_

5. Private Claims \_\_\_\_\_

I, NEIL L WAY, in a field survey on DEC. 18, 2000 do hereby state that under requirements of P.A. 74, Michigan P.A. of 1970, the corner points mentioned in lines 1 and 2 above were in conformance with regulations and rules therefore as required in the current manual of survey instructions of the United States Department of the Interior, Bureau of Land Management or by a decree of a Court of Law and /or that the corner points mentioned in lines 3, 4 and 5 above were in conformance with the rules of the Michigan Board of Land Surveyors or by a Decree of a Court of Law, established, re-established, monumented, recovered, found as expressed below.

**NOTE: Not more than 2 comers, all in the same town and range, may be recorded on this certificate.**

1	A	B	C	D	E	F	G	H	I	J	K	L	M
2		6		5		4		3		2		1	
3													
4		7		8		9		10		11		12	
5													
6		18		17		16		15		14		13	
7													
8		19		20		21		22		23		24	
9													
10		30		29		28		27		26		25	
11													
12		31		32		33		34		35		36	
13													

A. Description of original monument and accessories and/or subsequent restoration:

E-6 E 1/4 CORNER SEC. 17  
 GLO SET CORNER POST, A HEMLOCK 3 1/2" STAKE.  
 BEECH 5 N66 3/4 E 13 L  
 BEECH 5 S28 3/4 W 12 L  
 JOHN FERGUSON #24595, CERT. JAN. 7, 1985, SET A IRON AT SINGLE PRORATION MEASUREMENT.

3. Description of corner evidence found and/or method applied in restoring or reestablishing corner:

E-6 E 1/4 CORNER SEC. 17  
 FOUND IRON (FERGUSON) AS STATED ABOVE.

**SURVEY &  
 REMONUMENTATION**

**JAN 23 2001**

**SECTION**


B. Description of monument for corner and accessories established to perpetuate locating the position of the corner:

E-6 E 1/4 CORNER SEC. 17  
 ACCEPTED FERGUSON IRON AS CORNER, REMOVED AND REPLACED WITH COUNTY MONUMENT.

SOUTH 6.67' ASH 6"  
 N80E 14.27' POPLAR 5"  
 NORTH 7.43' CHERRY 6"  
 N25W 5.92' I. ROD

Ratified by Peer Group  
 In accordance with  
 P.A. 345  
 Antrim Co. Chairman

*Arthur L. Lennox*  
 Arthur L. Lennox, P.E., P.S.  
 Nov. 28, 2000

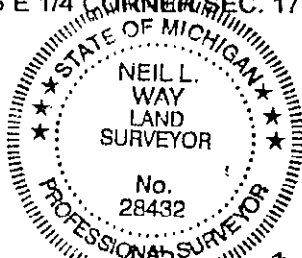

signed by *Neil L. Way*  
 surveyor's Michigan License No. 28432

Date DEC. 18, 2000