

LAND CORNER RECORDATION CERTIFICATE
Filing Requirement of Act 74, Mich. P.A. 1970

Liber **00003** Page **0146**

For corners in "ECHO TWP"

<u>ANTRIM</u> (County)	Located In:	Corner Code #
1. Public Land Survey	T 31N R 7W	E-7
	T R	
	T R	
	T R	
2. Property Controlling in Section	S T R	
	S T R	
3. Miscellaneous Property in Sec.	S T R	
	S T R	

ANTRIM COUNTY MI-
 Register of Deeds
 Recorded

12-21-2000 11:09:20

Manda R. Conway
 REGISTER OF DEEDS

Register of Deeds Stamp & File Number

4. Lot No. _____, Recorded Plat _____

5. Private Claims _____

I, NEIL L WAY, in a field survey on DEC. 18, 2000 do hereby state that under requirements of P.A. 74, Michigan P.A. of 1970, the corner points mentioned in lines 1 and 2 above were in conformance with regulations and rules therefore as required in the current manual of survey instructions of the United States Department of the Interior, Bureau of Land Management or by a decree of a Court of Law and /or that the corner points mentioned in lines 3, 4 and 5 above were in conformance with the rules of the Michigan Board of Land Surveyors or by a Decree of a Court of Law, established, re-established, monumented, recovered, found as expressed below:

NOTE: Not more than 2 corners, all in the same town and range, may be recorded on this certificate.

A	B	C	D	E	F	G	H	I	J	K	L	M
1												
2	6	5	4	3	2	1						
3												
4	7	8	9	10	11	12						
5												
6	18	17	16	15	14	13						
7												
8	19	20	21	22	23	24						
9												
10	30	29	28	27	26	25						
11												
12	31	32	33	34	35	36						
13												

A. Description of original monument and accessories and/or subsequent restoration:

E-7 SE CORNER SEC. 17
 GLO SET CORNER POST 1857
 BEECH 5 N66 3/4 E 13 L
 BEECH 5 S28 3/4 W 12 L
 L. FEINDT #21566, CERT. L 271, P 570 FOUND A 1" I.P.I.PE AND CEDAR STAKE.

3. Description of corner evidence found and/or method applied in restoring or reestablishing corner:

E-7 SE CORNER SEC. 17
 FOUND 1" I.P.I.PE AS STATED ABOVE.


**SURVEY &
 REMONUMENTATION**
JAN 23 2001
SECTION

2. Description of monument for corner and accessories established to perpetuate locating the position of the corner:

E-7 SE CORNER SEC. 17
 ACCEPTED 1" I.P.I.PE AS CORNER, REMOVED AND REPLACED WITH COUNTY MONUMENT.
 N10E 16.23' ASH 12" TW
 N25E 12.47' ASH 16"
 S75E 28.88' POPLAR 14"
 WEST 6.59' ASH 10"
 NORTH 8' CREEK

Ratified by Peer Group
 In accordance with
 P.A. 345
 Antrim Co. Chairman

Arthur L. Lennox
 Arthur L. Lennox, P.E., P.S.
 Nov. 28, 2000

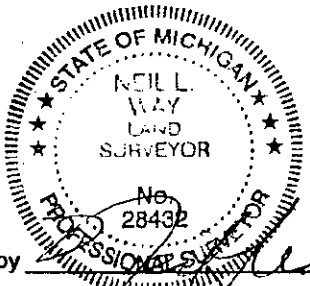

Signed by _____
 Surveyor's Michigan License No. 28432

Date DEC. 18, 2000