

LAND CORNER RECORDATION CERTIFICATE
Filing Requirement of Act 74, Mich. P.A. 1970

For corners in "ECHO TWP"

<u>ANTRIM</u> (County)	Located In:	Corner Code #
1. Public Land Survey	T <u>31N</u> R <u>7W</u>	F-7
	T _____ R _____	_____
	T _____ R _____	_____
	T _____ R _____	_____
2. Property Controlling in Section	S _____ T _____ R _____	_____
	S _____ T _____ R _____	_____
3. Miscellaneous Property in Sec.	S _____ T _____ R _____	_____
	S _____ T _____ R _____	_____

ANTRIM COUNTY MI.
 Register of Deeds
 Recorded

12-21-2000 11:07:52

Wanda R. Conway
 REGISTER OF DEEDS

Register of Deeds Stamp & File Number

4. Lot No. _____, Recorded Plat _____

5. Private Claims _____

I, NEIL L. WAY, in a field survey on DEC. 18, 2000 do hereby state that under requirements of P.A. 74, Michigan P.A. of 1970, the corner points mentioned in lines 1 and 2 above were in conformance with regulations and rules therefore as required in the current manual of survey instructions of the United States Department of the Interior, Bureau of Land Management or by a decree of a Court of Law and/or that the corner points mentioned in lines 3, 4 and 5 above were in conformance with the rules of the Michigan Board of Land Surveyors or by a Decree of a Court of Law, established, re-established, monumented, recovered, found as expressed below:

NOTE: Not more than 2 corners, all in the same town and range, may be recorded on this certificate.

1	A	B	C	D	E	F	G	H	I	J	K	L	M
2		6		5		4		3		2		1	
3													
4		7		8		9		10		11		12	
5													
6		18		17		16		15		14		13	
7													
8		19		20		21		22		23		24	
9													
10		30		29		28		27		26		25	
11													
12		31		32		33		34		35		36	
13													

A. Description of original monument and accessories and/or subsequent restoration:

F-7 S 1/4 CORNER SEC. 16
 GLO SET HEMLOCK 4" CORNER POST 1857

Y. BIRCH 11 N36 1/2 E 13 L
 HEMLOCK 12 S23 1/2 W 20L

L. FIENDT #21566, CERT. L 271, P 570, OCT. 23 1981 FOUND A 2" I.P.I.PE.

3. Description of corner evidence found and/or method applied in restoring or reestablishing corner:

F-7 S 1/4 CORNER SEC. 16
 FOUND 2" I.P.I.PE AS STATED ABOVE.

**SURVEY &
 REMONUMENTATION**

JAN 23 2001

SECTION


2. Description of monument for corner and accessories established to perpetuate locating the position of the corner:

F-7 S 1/4 CORNER SEC. 16


**ACCEPTED 2" I.P.I.PE AS CORNER, REMOVED AND
 REPLACED WITH COUNTY MONUMENT.**

N20W 15.97' POPLAR 10"
 N55W 26.09' MAPLE 10"
 S60W 22.38' MAPLE 10"
 S60E 15.83' MAPLE 8" TW

Ratified by Peer Group
 In accordance with
 P.A. 345
 Antrim Co. Chairman

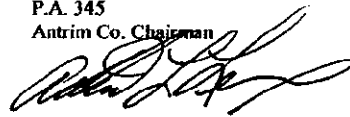

Arthur L. Lennox, P.E., P.S.
 Nov. 28, 2000

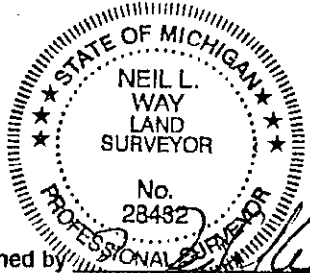

Signed by _____

Date DEC. 18, 2000

Surveyor's Michigan License No. 28432