

**SURVEY & REMONUMENTATION**

**JAN 28 2001**

Liber 00003 Page 0127

**SECTION**

**LAND CORNER RECORDATION CERTIFICATE TRIM COUNTY MI.**

Filing Requirement of Act 74, Mich. P.A. 1970  
 Register of Deeds  
 Filed

For corners in

<u>Antrim</u> (County)	Located In:	Echo Corner Code #
1. Public Land Survey	NE 15 T 31NR 7W	I-5
	T ___ R ___	_____
	T ___ R ___	_____
	T ___ R ___	_____
2. Property Controlling in Section	S ___ T ___ R ___	_____
	S ___ T ___ R ___	_____
3. Miscellaneous Property in Sec.	S ___ T ___ R ___	_____
	S ___ T ___ R ___	_____

12-18-2000 16:20:09

Wanda R. Conway  
 REGISTER OF DEEDS

Register of Deeds Stamp & File Number

1. Lot No. \_\_\_\_\_, Recorded Plat \_\_\_\_\_  
 2. Private Claims \_\_\_\_\_


Terry B. Smith, in a field survey on Dec. 7, 2000 do hereby state that under requirements of P.A. 74, Michigan P.A. of 1970, the corner points mentioned in lines 1 and 2 above were in conformance with regulations and rules therefore as required in the current manual of survey instructions of the United States Department of the Interior, Bureau of Land Management or by a decree of a Court of Law and/or that the corner points mentioned in lines 3, 4 and 5 above were in conformance with the rules of the Michigan Board of Land Surveyors or by a Decree of a Court of Law; established, re-established, monumented, discovered, found as expressed below:

	A	B	C	D	E	F	G	H	I	J	K	L	M
1													
2	6		5		4		3		2		1		
3													
4	7		8		9		10		11		12		
5													
6	18		17		16		15		14		13		
7													
8	19		20		21		22		23		24		
9													
10	30		29		28		27		26		25		
11													
12	31		32		33		34		35		36		
13													

NOTE: Not more than 2 corners, all in the same town and range, may be recorded on this certificate.

Description of original monument and accessories and/or subsequent restoration:

- 1857 GLO set sugar post 3 1/2"
- Sugar N623/4W 3 lks
- Sugar 11 S61 1/2 E 28 lks
- 1906 B. L. Caulkin, County Surveyor subdivision of Sec. 10
- 1972 LCRC by L. Gerschbacher
- 1992 certificate by J. Ferguson

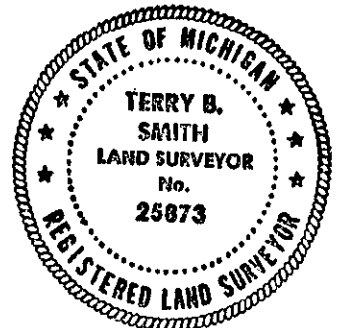

Description of corner evidence found and/or method applied in restoring or reestablishing corner:

Found 1/2" steel bar in roadway excavation -- found 3/8" pipe below surface (reference -- Liber 1 page 127) set by L. Gerschbacher from occupational evidence peer group long established local corner

Reviewed by Peer Group  
 In accordance with  
 P.A. 345  
 Antrim Co. Chairman

Description of monument for corner and accessories established to perpetuate locating the position of the corner:

- set antrim county monument over 1/2" bar
- corner chain link fence North 32.00
- 24" Maple N65W 74.70
- 30" Maple S60W 80.92
- 12" Maple N40E 31.68

Arthur L. Lennox, P.E., P.S.  
 Nov. 28, 2000

Ratified by Peer Group  
 In accordance with  
 P.A. 345  
 Antrim Co. Chairman

*Arthur L. Lennox*

Arthur L. Lennox, P.E., P.S.  
 Nov. 28, 2000

Signed by Terry B. Smith  
 Surveyor's Michigan License No. 25873

Date 12-18-2000