

JAN 23 2001

227  
Liber 000003 Page 0136

SECTION

LAND CORNER RECORDATION CERTIFICATE  
Filing Requirement of Act 74, Mich. P.A. 1970

ANTRIM COUNTY MI.  
Register of Deeds  
Filed

For corners in

Antrim

(County)

Located In:

Echo

Corner Code #

- 1. Public Land Survey E4 15 T 31NR 7W 1-6  
T R  
T R  
T R
- 2. Property Controlling in Section S T R  
S T R
- 3. Miscellaneous Property in Sec. S T R  
S T R

12-19-2000 16:23:41

Honda R. Conway  
REGISTER OF DEEDS

Register of Deeds Stamp & File Number

- 4. Lot No. \_\_\_\_\_, Recorded Plat \_\_\_\_\_
- 5. Private Claims \_\_\_\_\_


Terry B. Smith, in a field survey on Dec. 4, 2000 do hereby state that under equipments of P.A. 74, Michigan P.A. of 1970, the corner points mentioned in lines 1 and 2 above were in conformance with regulations and rules therefore as required in the current manual of survey instructions of the United States Department of the Interior, Bureau of Land Management or by a decree of a Court of Law and/or that the corner points mentioned in lines 3, 4 and 5 above were in conformance with the rules of the Michigan Board of Land Surveyors or by a Decree of a Court of Law; established, re-established, monumented, recovered, found as expressed below:

NOTE: Not more than 2 corners, all in the same town and range, may be recorded on this certificate.

	A	B	C	D	E	F	G	H	I	J	K	L	M
1													
2	6		5		4		3		2		1		
3													
4	7		8		9		10		11		12		
5													
6	18		17		16		15		14		13		
7													
8	19		20		21		22		23		24		
9													
10	30		29		28		27		26		25		
11													
12	31		32		33		34		35		36		
13													

1. Description of original monument and accessories and/or subsequent restoration:

- 1857 GLO set 3 1/2" sugar post
- Sugar 12 N26 1/4 W 33 lks
- Beech 22 S66E 22 lks
- NO OTHER RECORDS AVAILABLE

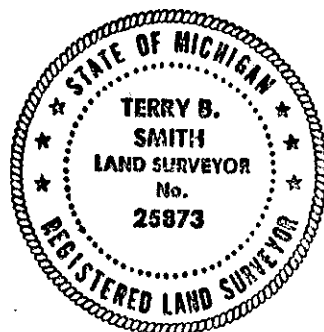

2. Description of corner evidence found and/or method applied in restoring or reestablishing corner:

Peer group meeting -- treat as a "Lost Corner" and establish midway and on line between I-5 and I-7

Traversing to said position a 1/2" steel bar with cap #24595 was found in the correct position.

3. Description of monument for corner and accessories established to perpetuate locating the position of the corner:

- Set Antrim county Monument adjacent to found 1/2" steel bar
- fence post N15E 4.00
- 18" Maple East 20.50
- 14" Maple S45E 31.65
- 30" Maple S22E, 19.75

Ratified by Peer Group  
In accordance with  
P.A. 345  
Antrim Co. Chairman

Arthur L. Lennox, P.E., P.S.  
Nov. 28, 2000

Signed by Terry B. Smith  
Surveyor's Michigan License No. 25873

Date 12-18-2000