SURVEY & REMONUMENTATION

JAN 23 2001

SECTION

Liber 00003 Page 0128

ANTRIM COUNTY MI.
Register of Deeds
Filed
12-18-2000 16:20:35

Wanda R. Conway
REGISTER OF DEEDS

Register of Deeds Stamp & File Number

LAND CORNER RECORDATION CERTIFICATE

Filing Requirement of Act 74, Mich. P.A. 1970

For corners in

Antrim (County) Located In: ECHO Corner Code #

1. Public Land Survey	14	T31N	R7W	J-7
		T___	R___	
		T___	R___	
		T___	R___	
2. Property Controlling in Section	S___	T___	R___	
	S___	T___	R___	
3. Miscellaneous Property in Sec.	S___	T___	R___	
	S___	T___	R___	

4. Lot No. _____ , Recorded Plat _____

5. Private Claims _____

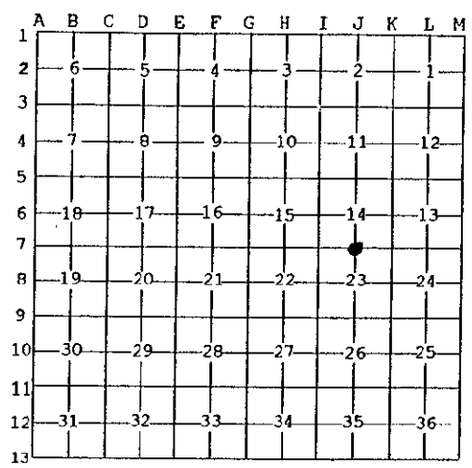

I, Terry B. Smith, in a field survey on Dec. 13, ~~19X~~ 2000 do hereby state that under requirements of P.A. 74, Michigan P.A. of 1970, the corner points mentioned in lines 1 and 2 above were in conformance with regulations and rules therefore as required in the current manual of survey instructions of the United States Department of the Interior, Bureau of Land Management or by a decree of a Court of Law and /or that the corner points mentioned in lines 3, 4 and 5 above were in conformance with the rules of the Michigan Board of Land Surveyors or by a Decree of a Court of Law; established, re-established, monumented, recovered, found as expressed below:

NOTE: Not more than 2 corners, all in the same town and range, may be recorded on this certificate.

A. Description of original monument and accessories and/or subsequent restoration:

1857 Govt. survey set 3½" Beech Post
Beech 4 N17W 43 lks
Beech 12 S243/4E 57 lks
1905 B. L. Caulkins, County Survey -- section subdivision
1979 A. Lennox reestablished midway and online
Liber 1 page 269 LCRC Lennox 1979

STATE OF MICHIGAN
TERRY B. SMITH
LAND SURVEYOR
No. 25873
REGISTERED LAND SURVEYOR

B. Description of corner evidence found and/or method applied in restoring or reestablishing corner:

Found ½" steel bar in road and witnesses per Liber 1 page 269
peer group "monument as a locally accepted corner" 2000

C. Description of monument for corner and accessories established to perpetuate locating the position of the corner:

12-13-00 set antrim county monument beside ½" steel bar
cable box N30E 60.55
UP S50E 84.70
UP N55W 124.90
Triple Maple S25W 80.35

Ratified by Peer Group
In accordance with
P.A. 345
Antrim Co. Chairman

Arthur L. Lennox, P.E., P.S.
Nov. 28, 2000

Signed by _____ Date 12-18-2000

Surveyor's Michigan License No. 25873

FORM APPROVED BY MICHIGAN STATE BOARD OF PROFESSIONAL SURVEYORS, JAN. 28, 1971
REVISED MAY 14,1975
REVISED JAN., 1983
REVISED OCT., 1995