

**SURVEY &
REMONUMENTATION**

FEB 11 1998

LAND CORNER RECORDATION CERTIFICATE
Filing Requirement of Act 74, Mich. P.A. 1970

ANTRIM COUNTY MI.
Register of Deeds
Recorded

For corners in SECTION

ANTRIM
(County)

Located In:

CENTRAL LAKE

Corner Code #

12-02-1997 08:52:40

Wanda R. Conway
REGISTER OF DEEDS

- | | | | | |
|---------------------------------------|------------|------------|------------|------------|
| 1. Public Land Survey | <u>5/4</u> | <u>T2N</u> | <u>R2W</u> | <u>D-9</u> |
| | <u>20</u> | T | R | |
| | | T | R | |
| | | T | R | |
| 2. Property Controlling
in Section | S | T | R | |
| | S | T | R | |
| 3. Miscellaneous
Property in Sec. | S | T | R | |
| | S | T | R | |

Register of Deeds Stamp & File Number

125

4. Lot No. _____, Recorded Plat _____
5. Private Claims _____

I, Terry B. Smith, in a field survey on 12-01, 19 97 do hereby state that under requirements of P.A. 74, Michigan P.A. of 1970, the corner points mentioned in lines 1 and 2 above were in conformance with regulations and rules therefore as required in the current manual of survey instructions of the United States Department of the Interior, Bureau of Land Management or by a decree of a Court of Law and/or that the corner points mentioned in lines 3, 4 and 5 above were in conformance with the rules of the Michigan Board of Land Surveyors or by a Decree of a Court of Law, established, re-established, monumented, recovered, found as expressed below:

	A	B	C	D	E	F	G	H	I	J	K	L	M
1													
2	6		5		4		3		2		1		
3													
4	7		8		9		10		11		12		
5													
6	18		17		16		15		14		13		
7													
8	19		20		21		22		23		24		
9													
10	30		29		28		27		26		25		
11													
12	31		32		33		34		35		36		
13													

NOTE: Not more than 2 corners, all in the same town and range, may be recorded on this certificate.

A. Description of original monument and accessories and/or subsequent restoration:

GLO Corner -- 3" Beech Post
Beech 15 N43 1/2 E 38L
Beech 12 S5 3/4 W 25L

B. Description of corner evidence found and/or method applied in restoring or reestablishing corner:

Surveys by Lennox & Assoc. (6 ea) 1975 -- 1996
Survey by T. O'Brien, 1974
Survey by G. Bonney 1988
LCRC Liber 001 page 167


C. Description of monument for corner and accessories established to perpetuate locating the position of the corner:

Found 1/2" bar & set Antrim County Monument
10" Elm S70°W 105.80
20" Maple Cluster S12°E 44.80
Fence Post S65°W 85.15
Spike in U.P. North 30.90
Concrete Monument North 33.0
Concrete Monument South 33.0

Ratified by Peer
Group in accordance
with P.A. 345
Antrim Co. Chairman

Arthur L. Lennox
Arthur L. Lennox
Nov. 18, 1997

Signed by T.B. Smith
Surveyor's Michigan License No. 25873

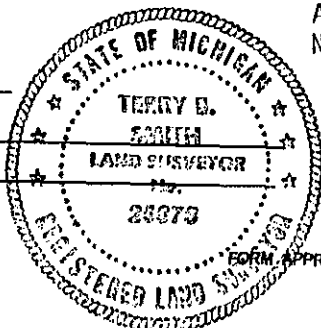

Date 12-01-1997