

SURVEY & REMONUMENTATION

FEB 11 1998

ANTRIM COUNTY MI.
Register of Deeds
Recorded

SECTION

LAND CORNER RECORDATION CERTIFICATE

Filing Requirement of Act 74, Mich. P.A. 1970

12-02-1997 08:52:51

For corners in

CENTRAL LAKE

ANTRIM
(County)

Located In:

Corner Code #

Wanda R. Conway
REGISTER OF DEEDS

- | | | | |
|------------------------------------|-----------|----------------|------------|
| 1. Public Land Survey | <u>21</u> | <u>T2N R3W</u> | <u>E-7</u> |
| | | T | R |
| | | T | R |
| | | T | R |
| | | T | R |
| 2. Property Controlling in Section | S | T | R |
| | S | T | R |
| 3. Miscellaneous Property in Sec. | S | T | R |
| | S | T | R |

Register of Deeds Stamp & File Number

124

4. Lot No. _____, Recorded Plat _____
5. Private Claims _____

I, Terry B. Smith, in a field survey on 12-01, 19 97 do hereby state that under requirements of P.A. 74, Michigan P.A. of 1970, the corner points mentioned in lines 1 and 2 above were in conformance with regulations and rules therefore as required in the current manual of survey instructions of the United States Department of the Interior, Bureau of Land Management or by a decree of a Court of Law and/or that the corner points mentioned in lines 3, 4 and 5 above were in conformance with the rules of the Michigan Board of Land Surveyors or by a Decree of a Court of Law; established, re-established, monumented, recovered, found as expressed below:

NOTE: Not more than 2 corners, all in the same town and range, may be recorded on this certificate.

	A	B	C	D	E	F	G	H	I	J	K	L	M
1													
2	6		5		4		3		2		1		
3													
4	7		8		9		10		11		12		
5													
6	18		17		16		15		14		13		
7													
8	19		20		21		22		23		24		
9													
10	30		29		28		27		26		25		
11													
12	31		32		33		34		35		36		
13													

A. Description of original monument and accessories and/or subsequent restoration:

GLO Corner -- 4" Beech Post
Beech 7 N2E 48L
Beech 11 S20 1/2 W 42L

B. Description of corner evidence found and/or method applied in restoring or reestablishing corner:

Surveys by Lennox & Assoc. (2 ea) 1976 -- 1988
Survey by C. Ostling 1973
Survey by A. Ranger 1994
Plat of Sunset Hills Liber 2 page 228
LCRC Liber 205 page 478
LCRC Liber 002 page 189

C. Description of monument for corner and accessories established to perpetuate locating the position of the corner:

Found 1" Pipe & set Antrim County Monument
18" Poplar N32°W 12.0
30" Maple S52°E 20.18
24" Maple S45°W 20.90
12" Maple S85°W 51.45
14" Maple S59°E 45.25
24" Beech S10°W 40.60


Ratified by Peer
Group in accordance
with P.A. 345
Antrim Co. Chairman

Arthur L. Lennox

Arthur L. Lennox
Nov. 18, 1997

Signed by T.B. Smith
Surveyor's Michigan License No. 25873

Date 12-01-1997

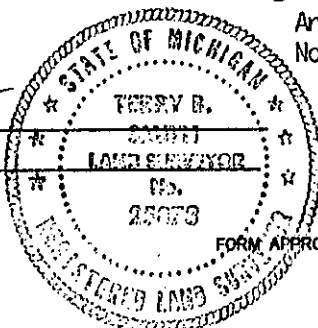

LIBER 0002 PAGE 189