

SURVEY & REMONUMENTATION

FEB 11 1998

SECTION

LAND CORNER RECORDATION CERTIFICATE
 Filing Requirement of Act 74, Mich. P.A. 1970
CENTRAL LAKE

ANTRIM COUNTY MI.
 Register of Deeds
 Recorded

12-02-1997 08:53:25

For corners in

Antrim
 (County)

Located In:

Corner Code #

Wanda R. Conway
 REGISTER OF DEEDS

- 1. Public Land Survey 21 T12N R20W E-8
 T___ R___
 T___ R___
 T___ R___
- 2. Property Controlling in Section S___ T___ R___
 S___ T___ R___
- 3. Miscellaneous Property in Sec. S___ T___ R___
 S___ T___ R___

Register of Deeds Stamp & File Number

120

- 4. Lot No. _____, Recorded Plat _____
- 5. Private Claims _____

	A	B	C	D	E	F	G	H	I	J	K	L	M
1													
2	6		5		4		3		2		1		
3													
4	7		8		9		10		11		12		
5													
6	18		17		16		15		14		13		
7													
8	19		20		21		22		23		24		
9													
10	30		29		28		27		26		25		
11													
12	31		32		33		34		35		36		
13													

I, Terry B. Smith, in a field survey on 12-01, 19 97 do hereby state that under requirements of P.A. 74, Michigan P.A. of 1970, the corner points mentioned in lines 1 and 2 above were in conformance with regulations and rules therefore as required in the current manual of survey instructions of the United States Department of the Interior, Bureau of Land Management or by a decree of a Court of Law and/or that the corner points mentioned in lines 3, 4 and 5 above were in conformance with the rules of the Michigan Board of Land Surveyors or by a Decree of a Court of Law; established, re-established, monumented, recovered, found as expressed below:

NOTE: Not more than 2 corners, all in the same town and range, may be recorded on this certificate.

A. Description of original monument and accessories and/or subsequent restoration:

GLO Corner --4" Beech Post
 Beech 7" N2E 48L
 Beech 11" S20½W 42L

B. Description of corner evidence found and/or method applied in restoring or reestablishing corner:

Survey by N. DeYoung 1976


C. Description of monument for corner and accessories established to perpetuate locating the position of the corner:

Found ½" iron bar & set Antrim County Monument
 12" Maple S20°W 34.15
 24" Maple N84°W 16.15
 20" Maple N78°E 10.00
 8" Ironwood N21°E 25.55

Ratified by Peer
 Group in accordance
 with P.A. 345
 Antrim Co. Chairman

Arthur L. Lennox
 Arthur L. Lennox
 18, 1997

Signed by T.B. Smith
 Surveyor's Michigan License No. 25873

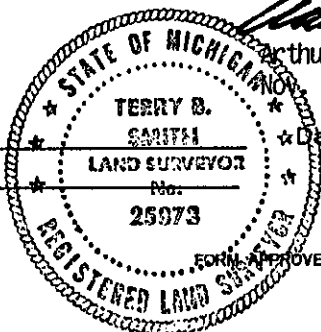

Date 12-01-1997

Liber 00002 Page 0414