

SURVEY & REMONUMENTATION

FEB 11 1998

SECTION

LAND CORNER RECORDATION CERTIFICATE

Filing Requirement of Act 74, Mich. P.A. 1970

CENTRAL LAKE

ANTRIM COUNTY MI.
Register of Deeds
Recorded

12-02-1997 08:52:59

Wanda R. Conway
REGISTER OF DEEDS

For corners in

ANTRIM
(County)

Located In:

Corner Code #

1. Public Land Survey 21

T21N R 2W

F-7

T ___ R ___

T ___ R ___

T ___ R ___

T ___ R ___

2. Property Controlling in Section

S ___ T ___ R ___

S ___ T ___ R ___

3. Miscellaneous Property in Sec.

S ___ T ___ R ___

S ___ T ___ R ___

4. Lot No. _____, Recorded Plat _____
5. Private Claims _____

I, Terry B. Smith, in a field survey on 12-01, 1997 do hereby state that under requirements of P.A. 74, Michigan P.A. of 1970, the corner points mentioned in lines 1 and 2 above were in conformance with regulations and rules therefore as required in the current manual of survey instructions of the United States Department of the Interior, Bureau of Land Management or by a decree of a Court of Law and/or that the corner points mentioned in lines 3, 4 and 5 above were in conformance with the rules of the Michigan Board of Land Surveyors or by a Decree of a Court of Law; established, re-established, monumented, recovered, found as expressed below:

NOTE: Not more than 2 corners, all in the same town and range, may be recorded on this certificate.

Register of Deeds Stamp & File Number

123

	A	B	C	D	E	F	G	H	I	J	K	L	M
1													
2	6		5		4		3		2				
3													
4	7		8		9		10		11		12		
5													
6	18		17		16		15		14		13		
7													
8	19		20		21		22		23		24		
9													
10	30		29		28		27		26		25		
11													
12	31		32		33		34		35		36		
13													

A. Description of original monument and accessories and/or subsequent restoration:

GLD Corner -- 3" Beech Post
Beech 15 N47E 5L
Beech 9 S51½W 36L

B. Description of corner evidence found and/or method applied in restoring or reestablishing corner:

Surveys by Lennox & Assoc. (2 ea) 1976 -- 1988
Survey by B. Jones 1977

Plat of Sunset Hills Liber 2 page 228

C. Description of monument for corner and accessories established to perpetuate locating the position of the corner:

Found 1½" Axle Shaft & set Antrim County Monument
8" Elm S20°W 122.60
7" Red Pine S50°W 65.20
8" Red Pine S80°W 120.05
14" Maple North 149.60

Ratified by Peer
Group in accordance
with P.A. 345
Antrim Co. Chairman


Arthur L. Lennox
Nov. 18, 1997

Date 12-01-1997

Signed by

T.B. Smith

Surveyor's Michigan License No. 25873

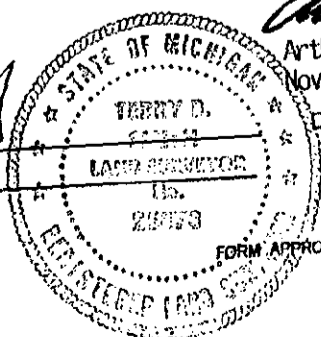

Liber 00002 Page 0411