

SURVEY & REMONUMENTATION

FEB 11 1998

ANTRIM COUNTY MI.
Register of Deeds
Recorded
12-02-1997 08:53:08

LAND CORNER RECORDATION CERTIFICATE
Filing Requirement of Act 74, Mich. P.A. 1970
CENTRAL LAKE

SECTION

For corners in

Located In: Corner Code #

ANTRIM
(County)

Wanda R. Conway
REGISTER OF DEEDS

1. Public Land Survey 21 T34N R8W F-9
T R
T R
T R
T R
2. Property Controlling S T R
in Section S T R
3. Miscellaneous S T R
Property in Sec. S T R

Register of Deeds Stamp & File Number

122

4. Lot No. _____, Recorded Plat _____
5. Private Claims _____

I, Terry B. Smith, in a field survey on 12-01, 1997 do hereby state that under requirements of P.A. 74, Michigan P.A. of 1970, the corner points mentioned in lines 1 and 2 above were in conformance with regulations and rules therefore as required in the current manual of survey instructions of the United States Department of the Interior, Bureau of Land Management or by a decree of a Court of Law and /or that the corner points mentioned in lines 3, 4 and 5 above were in conformance with the rules of the Michigan Board of Land Surveyors or by a Decree of a Court of Law; established, re-established, monumented, recovered, found as expressed below:

NOTE: Not more than 2 corners, all in the same town and range, may be recorded on this certificate.

	A	B	C	D	E	F	G	H	I	J	K	L	M
1													
2	6		5		4		3		2		1		
3													
4	7		8		9		10		11		12		
5													
6	18		17		16		15		14		13		
7													
8	19		20		21		22		23		24		
9													
10	30		29		28		27		26		25		
11													
12	31		32		33		34		35		36		
13													

A. Description of original monument and accessories and/or subsequent restoration:

GLO Corner -- 4 1/2" Beech Post
Beech 11 N53W 12L
Beech 16 S80 1/2 E 9

B. Description of corner evidence found and/or method applied in restoring or reestablishing corner:

Survey by Lennox & Assoc. 1992


C. Description of monument for corner and accessories established to perpetuate locating the position of the corner:

Found 1/2" iron bar & set Antrim County Monument
Bolder N23°W 144.60
Stop Sign S65°E 50.20
U.P. S18°E 97.10
Basswood Clump S25°W 68.60
West Edge of Roadway 11.30

Ratified by Peer
Group in accordance
with P.A. 345
Antrim Co. Chairman

Arthur L. Lennox
Nov. 18, 1997

Signed by T.B. Smith
Surveyor's Michigan License No. 25873

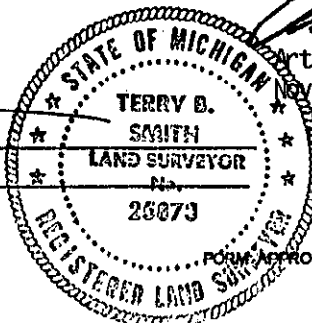

Date 12-01-1997

Liber 00002 Page 0412