

SURVEY & REMONUMENTATION

FEB 11 1998

Liber **00002** Page **0427**

SECTION

LAND CORNER RECORDATION CERTIFICATE
Filing Requirement of Act 74, Mich. P.A. 1970

For corners in **CENTRAL LAKE TWP.**

ANTRIM

(County)

Located In:

Corner Code #

1. Public Land Survey NW S 22	T <u>31</u> N R <u>8</u> W	<u>G-7</u>
	T <u> </u> R <u> </u>	<u> </u>
	T <u> </u> R <u> </u>	<u> </u>
	T <u> </u> R <u> </u>	<u> </u>
2. Property Controlling in Section	S <u> </u> T <u> </u> R <u> </u>	<u> </u>
	S <u> </u> T <u> </u> R <u> </u>	<u> </u>
3. Miscellaneous Property in Sec.	S <u> </u> T <u> </u> R <u> </u>	<u> </u>
	S <u> </u> T <u> </u> R <u> </u>	<u> </u>

ANTRIM COUNTY MI.
Register of Deeds
Recorded

12-15-1997 08:52:23

Wanda R. Conway
REGISTER OF DEEDS

Register of Deeds Stamp & File Number

129

4. Lot No. _____, Recorded Plat _____
5. Private Claims _____

I, NEIL L. WAY, in a field survey on 19 NOV., 1997 do hereby state that under requirements of P.A. 74, Michigan P.A. of 1970, the corner points mentioned in lines 1 and 2 above were in conformance with regulations and rules therefore as required in the current manual of survey instructions of the United States Department of the Interior, Bureau of Land Management or by a decree of a Court of Law and for that the corner points mentioned in lines 3, 4 and 5 above were in conformance with the rules of the Michigan Board of Land Surveyors or by a Decree of a Court of Law; established, re-established, monumented, recovered, found as expressed below.

NOTE: Not more than 2 corners, all in the same town and range, may be recorded on this certificate.

A	B	C	D	E	F	G	H	I	J	K	L	M
1												
2	6		5		4		3		2		1	
3												
4	7		8		9		10		11		12	
5												
6	18		17		16		15		14		13	
7												
8	19		20		21		22		23		24	
9												
10	30		29		28		27		26		25	
11												
12	31		32		33		34		35		36	
13												

A. Description of original monument and accessories and/or subsequent restoration:
GLO SET HEMLOCK POST APRIL 1857, IRONWOOD 11 N60 1/4W 31, SUGAR 12 S37 3/4E 28
A. LENNOX (#20357) JUNE 1986, FOUND NAIL & WIT. (L.002 P.21)
SET 1/2" BAR & CAP
14" MAPLE SOUTH 53.0
UP. N60W 73.60
8" R. PINE N20W 23.5

B. Description of corner evidence found and/or method applied in restoring or reestablishing corner:
1/2" FOUND IRON RE-ROD & WIT'S, 0.3' BELOW GRAVEL SURFACE, 6' NORTH OF CENTERLINE MEGGISON ROAD.


Ratified by Peer Group in accordance with P.A. 345 Antrim Co. Chairman

Arthur L. Lennox
Arthur L. Lennox
Nov. 18, 1997

C. Description of monument for corner and accessories established to perpetuate the position of the corner:
SET ANTRIM COUNTY MONUMENT, 0.5' BELOW GRAVEL SURFACE

N63W 73.61' FOUND NAIL NE/SIDE POWER POLE
N31W 23.51' SET NAIL E/SIDE 15" RED PINE
SOUTH 33.94' 1/2" FOUND IRON RE-ROD & CAP (#23514 B.JONES)
SOUTH 47.88' SET NAIL W/SIDE 14" MAPLE
S33E 65.91' FOUND NAIL SE/SIDE 22" MAPLE

Signed by *Neil L. Way*
Surveyor's Michigan License No. 28432

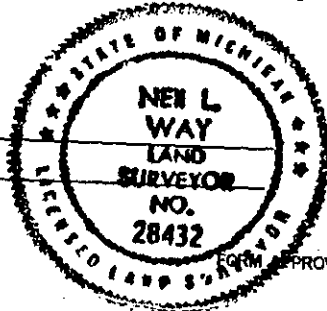

Date 26 NOV. 1997