

SURVEY & REMONUMENTATION

FEB 11 1998

SECTION

LAND CORNER RECORDATION CERTIFICATE
Filing Requirement of Act 74, Mich. P.A. 1970

ANTRIM COUNTY MI.
Register of Deeds
Recorded
12-02-1997 08:53:43

For corners in

Antrim
(County)

Located in:

Corner Code #

Manda R. Conway
REGISTER OF DEEDS

- 1. Public Land Survey E 1/4 T31N R 8W 6-8
21
- 2. Property Controlling in Section S ___ T ___ R ___
- 3. Miscellaneous Property in Sec. S ___ T ___ R ___

Register of Deeds Stamp & File Number

118

- 4. Lot No. _____, Recorded Plat _____
- 5. Private Claims _____

I, Terry B. Smith, in a field survey on 12-01, 19 97 do hereby state that under requirements of P.A. 74, Michigan P.A. of 1970, the corner points mentioned in lines 1 and 2 above were in conformance with regulations and rules therefore as required in the current manual of survey instructions of the United States Department of the Interior, Bureau of Land Management or by a decree of a Court of Law and /or that the corner points mentioned in lines 3, 4 and 5 above were in conformance with the rules of the Michigan Board of Land Surveyors or by a Decree of a Court of Law; established, re-established, monumented, recovered, found as expressed below:

NOTE: Not more than 2 corners, all in the same town and range, may be recorded on this certificate.

| | A | B | C | D | E | F | G | H | I | J | K | L | M |
|----|---|----|---|----|---|----|---|----|---|----|---|----|---|
| 1 | | | | | | | | | | | | | |
| 2 | | 6 | | 5 | | 4 | | 3 | | 2 | | 1 | |
| 3 | | | | | | | | | | | | | |
| 4 | | 7 | | 8 | | 9 | | 10 | | 11 | | 12 | |
| 5 | | | | | | | | | | | | | |
| 6 | | 10 | | 17 | | 16 | | 15 | | 14 | | 13 | |
| 7 | | | | | | | | | | | | | |
| 8 | | 19 | | 20 | | 21 | | 22 | | 23 | | 24 | |
| 9 | | | | | | | | | | | | | |
| 10 | | 30 | | 29 | | 28 | | 27 | | 26 | | 25 | |
| 11 | | | | | | | | | | | | | |
| 12 | | 31 | | 32 | | 33 | | 34 | | 35 | | 36 | |
| 13 | | | | | | | | | | | | | |

A. Description of original monument and accessories and/or subsequent restoration:

GLO Corner -- 3" Sugar Post
Lynn 17" N51 1/2 E 35L
Beech 15" N74W 9L

B. Description of corner evidence found and/or method applied in restoring or reestablishing corner:

Survey by Lennox & Assoc. 1986

LCRC Liber 002 page 21

C. Description of monument for corner and accessories established to perpetuate locating the position of the corner:

Found 1/2" iron & set Antrim County Monument
8" Twin Ash South 14.00
14" Maple N30°W 22.50
12" Maple S65°W 36.40
12" Maple N15°E 15.50


Ratified by peer group in accordance with P.A. 345 Antrim Co. Chairman

Arthur L. Lennox

Arthur L. Lennox

Nov. 18, 1997 12-01-1997

Signed by T.B. Smith
Surveyor's Michigan License No. 25873

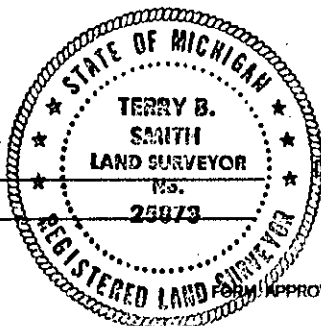

Liber 00002 Page 0416