

SURVEY & REMONUMENTATION

FEB 11 1998

ANTRIM COUNTY MI.
Register of Deeds
Recorded

LAND CORNER RECORDATION CERTIFICATE

Filing Requirement of Act 74, Mich. P.A. 1970

12-02-1997 08:53:16

For corners in **SECTION**

Antrim
(County)

Located In:

Corner Code #

Wanda R. Conway
REGISTER OF DEEDS

1. Public Land Survey 21 TURON G-9
 T___R___
 T___R___
 T___R___
 2. Property Controlling in Section S___T___R___
 S___T___R___
 3. Miscellaneous S___T___R___
 Property in Sec. S___T___R___

Register of Deeds Stamp & File Number

121

4. Lot No. _____, Recorded Plat _____

5. Private Claims _____

I, Terry B. Smith, in a field survey on 12-01, 19 97 do hereby state that under requirements of P.A. 74, Michigan P.A. of 1970, the corner points mentioned in lines 1 and 2 above were in conformance with regulations and rules therefore as required in the current manual of survey instructions of the United States Department of the Interior, Bureau of Land Management or by a decree of a Court of Law and/or that the corner points mentioned in lines 3, 4 and 5 above were in conformance with the rules of the Michigan Board of Land Surveyors or by a Decree of a Court of Law; established, re-established, monumented, recovered, found as expressed below:

NOTE: Not more than 2 corners, all in the same town and range, may be recorded on this certificate.

	A	B	C	D	E	F	G	H	I	J	K	L	M
1													
2	6		5		4		3		2		1		
3													
4	7		8		9		10		11		12		
5													
6	18		17		16		15		14		13		
7													
8	19		20		21		22		23		24		
9													
10	30		29		28		27		26		25		
11													
12	31		32		33		34		35		36		
13													

A. Description of original monument and accessories and/or subsequent restoration:

GLO Corner --Post at 79.23 Ch.

B. Description of corner evidence found and/or method applied in restoring or reestablishing corner:

Surveys by Lennox & Assoc. 1978 -- 1986
 LCRC Liber 240 page 653
 LCRC Liber 002 page 21

C. Description of monument for corner and accessories established to perpetuate locating the position of the corner:

Found 3/4" iron pipe & set Antrim County Monument
 10" Maple N70°E 5.15
 8" Maple S46°E 11.48
 14" Maple S10°E 11.45
 10" Maple N74°W 14.40


Ratified by Peer
 Group in accordance
 with P.A. 345
 Antrim Co. Chairman

Arthur L. Lennox
 Nov. 18, 1997

Date 12-01-1997

Signed by T.B. Smith

Surveyor's Michigan License No. 25873

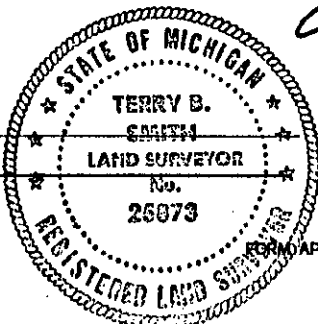

Liber 00002 Page 0413