

SURVEY & REMONUMENTATION

FEB 11 1998

Liber **00002** Page **0428**

LAND CORNER RECORDATION CERTIFICATE
Filing Requirement of Act 74, Mich. P.A. 1970

For corners in **SECTION** **CENTRAL LAKE TWP.**

ANTRIM (County)	Located In:	Corner Code #
1. Public Land Survey N $\frac{1}{4}$ S 22 T 31N R 8W		H - 7
	T R	
	T R	
	T R	
2. Property Controlling in Section	S T R	
	S T R	
3. Miscellaneous Property in Sec.	S T R	
	S T R	

ANTRIM COUNTY MI.
Register of Deeds
Recorded

12-15-1997 08:52:36

Manda R. Conway
REGISTER OF DEEDS

Register of Deeds Stamp & File Number
128

- 4. Lot No. , Recorded Plat
- 5. Private Claims

I, Neil L. Way, in a field survey on 10 Dec. 1997 do hereby state that under requirements of P.A. 74, Michigan P.A. of 1970, the corner points mentioned in lines 1 and 2 above were in conformance with regulations and rules therefore as required in the current manual of survey instructions of the United States Department of the Interior, Bureau of Land Management or by a decree of a Court of Law and /or that the corner points mentioned in lines 3, 4 and 5 above were in conformance with the rules of the Michigan Board of Land Surveyors or by a Decree of a Court of Law; established, re-established, monumented, recovered, found as expressed below:

NOTE: Not more than 2 corners, all in the same town and range, may be recorded on this certificate.

	A	B	C	D	E	F	G	H	I	J	K	L	M
1													
2		6		5		4		3		2		1	
3													
4		7		8		9		10		11		12	
5													
6		10		17		16		15		14		13	
7													
8		19		20		21		22		23		24	
9													
10		30		29		28		27		26		25	
11													
12		31		32		33		34		35		36	
13													

A. Description of original monument and accessories and/or subsequent restoration:

GLO SET CEDAR POST APRIL 1857, LYNN 14 N 3 $\frac{1}{2}$ W 50, HEMLOCK 20 S 34 $\frac{1}{4}$ W 22

Ratified by Peer
Group in accordance
with P.A. 345
Antrim Co. Chairman

Arthur L. Lennox
Arthur L. Lennox
Nov. 18, 1997

B. Description of corner evidence found and/or method applied in restoring or reestablishing corner:


FOUND NO CORNER AT LOCATION AS SHOWN ON CERTIFICATE BY LENNOX AND ASSO.
Job # 92011 -- 3-04-92. NOTE: 13' SOUTH OF CORNER LOCATION (MID WAY ON-LINE) FOUND B.JONES #23514 OF NO RECORD.

SET ANTRIM COUNTY MONUMENT AT SINGLE PROP. MEAS. IN MONUMENT BOX 12' S. OF CENTERLINE M 88. AT MID POINT AND ON LINE BETWEEN NE AND NW CORNERS.

C. Description of monument for corner and accessories established to perpetuate locating the position of the corner:

SEC ANTRIM COUNTY MONUMENT AT GRADE IN SHOULDER OF ROAD.

- N. 37 E 83.53' SET NAIL P. POLE
- S 40 E 22.20' SET NAIL 4" CEDAR
- S 56 W 49.00' SET NAIL 4" CEDAR
- SOUTH 13.04' B.JONES IRON AND CAP OF NO RECORD.
- NORTH 12' CENTERLINE M 88 HIGHWAY

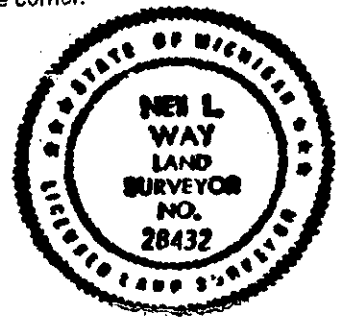

Signed by *Neil L. Way*
Surveyor's Michigan License No. 28432

Date 11 DECEMBER 1997