

SURVEY & REMONUMENTATION

FEB 11 1998

Liber 00002 Page 0424

SECTION

LAND CORNER RECORDATION CERTIFICATE
Filing Requirement of Act 74, Mich. P.A. 1970

For corners in CENTRAL LAKE TWP.

<u>ANTRIM</u> (County)	Located In:	Corner Code #
1. Public Land Survey E 1/4 S 15	T 31 N R 8 W	I-6
	T ___ R ___	_____
	T ___ R ___	_____
	T ___ R ___	_____
2. Property Controlling in Section	S ___ T ___ R ___	_____
	S ___ T ___ R ___	_____
3. Miscellaneous Property in Sec.	S ___ T ___ R ___	_____
	S ___ T ___ R ___	_____
4. Lot No. _____, Recorded Plat _____		
5. Private Claims _____		

ANTRIM COUNTY MI.
Register of Deeds
Recorded

12-15-1997 08:51:49

Wanda R. Conway
REGISTER OF DEEDS

Register of Deeds Stamp & File Number
132

I, NEIL L. WAY, in a field survey on 19 NOV. 1997 do hereby state that under requirements of P.A. 74, Michigan P.A. of 1970, the corner points mentioned in lines 1 and 2 above were in conformance with regulations and rules therefore as required in the current manual of survey instructions of the United States Department of the Interior, Bureau of Land Management or by a decree of a Court of Law and/or that the corner points mentioned in lines 3, 4 and 5 above were in conformance with the rules of the Michigan Board of Land Surveyors or by a Decree of a Court of Law, established, re-established, monumented, recovered, found as expressed below:

NOTE: Not more than 2 corners, all in the same town and range, may be recorded on this certificate.

	A	B	C	D	E	F	G	H	I	J	K	L	M
1													
2	6		5		4		3		2		1		
3													
4	7		8		9		10		11		12		
5													
6	18		17		16		15		14		13		
7													
8	19		20		21		22		23		24		
9													
10	30		29		28		27		26		25		
11													
12	31		32		33		34		35		36		
13													

A. Description of original monument and accessories and/or subsequent restoration:
GLO SET CEDAR POST APRIL 1857, HEMLOCK 12 N51 1/2E 20, HEMLOCK 9 S51 1/2W 37

Ratified by Peer
Group in accordance
with P.A. 345
Antrim Co. Chairman

Arthur L. Lennox
Arthur L. Lennox
Nov. 18, 1997

B. Description of corner evidence found and/or method applied in restoring or reestablishing corner:
1 1/2" FOUND IRON PIPE, 0.2' BELOW GRADE, 36' +/- WEST OF EDGE OF WATER HANLEY LAKE, IN EAST LAWN OF HOUSE #3480 CHILDS LANE, & WIT'S


L.FEINDT #21566 JULY 1979 (L.244 P.981) 1 1/2" IRON PIPE FOUND, 16" BIRCH NORTH 39.06', 6" MAPLE SOUTH 53.20', 22" MAPLE WEST 41.58'

S.CHAMBERLAIN #25834 MAR. 1985 (L.295 P.170), FOUND 1 1/2" PIPE, NORTH 39.05' 16" BIRCH (N.B.DEYOUNG), SOUTH 53.20' 6" MAPLE (N.B.DEYOUNG), WEST 41.58' 22" MAPLE (C.A.&E. CO.)

C. Description of monument for corner and accessories established to perpetuate locating the position of the corner:
SET ANTRIM COUNTY MONUMENT, 0.4' BELOW GRADE

N88W 42.70' FOUND NAIL & WASHER N/SIDE 30" STUMP
N40W 40.75' SET NAIL E/SIDE 14" CHERRY
N04E 39.50' SET NAIL (ABOVE GROWN OVER NAIL & WASHER) E/SIDE 24" BIRCH
S07E 53.45' FOUND NAIL & WASHER E/SIDE 12" ELM

Signed by *Neil L. Way*
Surveyor's Michigan License No. 28432

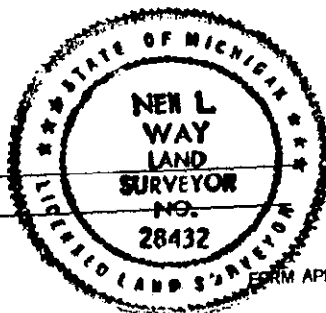

Date 25 NOVEMBER 1997