

SURVEY & REMONUMENTATION

FEB 11 1998

Liber **00002** Page **0426**

SECTION

LAND CORNER RECORDATION CERTIFICATE
Filing Requirement of Act 74, Mich. P.A. 1970

For corners in **CENTRAL LAKE TWP.**

<u>ANTRIM</u> (County)	Located In:	Corner Code #
1. Public Land Survey E $\frac{1}{4}$ S 22 T 31NR 8W		I-8
	T R	
	T R	
	T R	
2. Property Controlling in Section	S T R	
	S T R	
3. Miscellaneous Property in Sec.	S T R	
	S T R	

ANTRIM COUNTY MI.
Register of Deeds
Recorded

12-15-1997 08:52:13

Manda R. Conway
REGISTER OF DEEDS

Register of Deeds Stamp & File Number
130

4. Lot No. _____, Recorded Plat _____
5. Private Claims _____

I, NEIL L. WAY, in a field survey on 19 NOV., 1997 do hereby state that under requirements of P.A. 74, Michigan P.A. of 1970, the corner points mentioned in lines 1 and 2 above were in conformance with regulations and rules therefore as required in the current manual of survey instructions of the United States Department of the Interior, Bureau of Land Management or by a decree of a Court of Law and/or that the corner points mentioned in lines 3, 4 and 5 above were in conformance with the rules of the Michigan Board of Land Surveyors or by a Decree of a Court of Law; established, re-established, monumented, recovered, found as expressed below:

NOTE: Not more than 2 corners, all in the same town and range, may be recorded on this certificate.

	A	B	C	D	E	F	G	H	I	J	K	L	M
1													
2		6		5		4		3		2		1	
3													
4		7		8		9		10		11		12	
5													
6		18		17		16		15		14		13	
7													
8		19		20		21		22		23		24	
9													
10		30		29		28		27		26		25	
11													
12		31		32		33		34		35		36	
13													

A. Description of original monument and accessories and/or subsequent restoration:
GLO SET ELM POST APRIL 1857, SUGAR 20 N62 3/4E 24, BEECH 10 S66 3/4W 42

B. Description of corner evidence found and/or method applied in restoring or reestablishing corner:
FOUND 3/8" IRON ROD IN MON. BOX AND WIT'S, IN CENTERLINE M-88 NORTH-SOUTH, 7' NORTH OF CENTERLINE NORTH ST. TO THE EAST


A. LENNOX (#20357) F 3/8 BAR IN CONC. (L. 226 P.798)
UP N45E 34.73
UP S35E 61.28

Ratified by Peer
Group in accordance
with P.A. 345
Antrim Co. Chairman

C. Description of monument for corner and accessories established to perpetuate and/or mark the location of the corner:
SET ANTRIM COUNTY MONUMENT IN MON. BOX
Date: Nov. 18, 1997

N37W 32.96' FOUND NAIL SW/SIDE POWER POLE
N53E 34.88' FOUND NAIL SE/SIDE POWER POLE
S12E 61.62' FOUND NAIL SW/SIDE LIGHT POLE
S50W 96.80' NE CORNER OF BLOCK BUILDING

Signed by Neil L. Way
Surveyor's Michigan License No. 28432

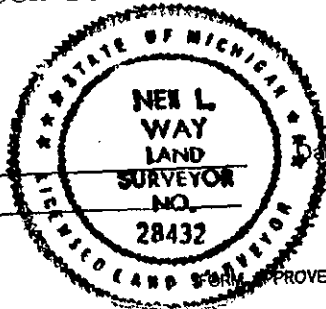

Date 26 NOVEMBER 1997