

SURVEY & REMONUMENTATION

FEB 11 1998

Liber 00002 Page 0425

SECTION

LAND CORNER RECORDATION CERTIFICATE
Filing Requirement of Act 74, Mich. P.A. 1970

For corners in CENTRAL LAKE TWP.

<u>ANTRIM</u> (County)	Located In:	Corner Code #
1. Public Land Survey	SE S 22 T 31NR 8W	I-9
	T R	
	T R	
	T R	
2. Property Controlling in Section	S T R	
	S T R	
3. Miscellaneous Property in Sec.	S T R	
	S T R	

ANTRIM COUNTY MI.
Register of Deeds
Recorded

12-15-1997 08:51:59

Wanda R. Conway
REGISTER OF DEEDS

Register of Deeds Stamp & File Number

131

4. Lot No. _____, Recorded Plat _____
5. Private Claims _____

	A	B	C	D	E	F	G	H	I	J	K	L	M
1													
2	6		5		4		3		2		1		
3													
4	7		8		9		10		11		12		
5													
6	18		17		16		15		14		13		
7													
8	19		20		21		22		23		24		
9													
10	30		29		28		27		26		25		
11													
12	31		32		33		34		35		36		
13													

I, NEIL L. WAY, in a field survey on 19 NOV., 1997 do hereby state that under requirements of P.A. 74, Michigan P.A. of 1970, the corner points mentioned in lines 1 and 2 above were in conformance with regulations and rules therefore as required in the current manual of survey instructions of the United States Department of the Interior, Bureau of Land Management or by a decree of a Court of Law and for that the corner points mentioned in lines 3, 4 and 5 above were in conformance with the rules of the Michigan Board of Land Surveyors or by a Decree of a Court of Law; established, re-established, monumented, recovered, found as expressed below:

NOTE: Not more than 2 corners, all in the same town and range, may be recorded on this certificate.

A. Description of original monument and accessories and/or subsequent restoration:

GLO SET IRONWOOD POST OCT. 1856, SUGAR 13 N50 1/2W 31, SUGAR 14 S56 1/4E 47

CHURCH (CO. SURVEYOR) APRIL 1884, A BURIED IRON WITH POINT 1x1/2" AT SURFACE, COUNTY SURVEYOR'S RECORD P.323

B. Description of corner evidence found and/or method applied in restoring or reestablishing corner:

FOUND 1/2" IRON RE-ROD & WIT'S, 0.1' BELOW PAVEMENT SURFACE, IN CENTERLINE M-88 NORTH-SOUTH AND 7' SOUTH OF CENTERLINE CAMERON ST. TO WEST

A. ERICKSON #607 JUNE 1957, IRON STAKE FOUND JUST BELOW SURFACE OF BLACKTOP
M. FEINDT #3920 SEP. 1974, S65E 43.00' 24" WALNUT, EAST 47.30' 22" HEMLOCK, N45E 62.15' POWER POLE (L.220 P.926)

A. LENNOX #20357 JUNE 1976, FND. 1/2" BAR, UP N45W 44.0, 30" HEMLOCK EAST 47.4, 30" LOCUST 42.75 (L.226 P.799)

B. JONES #23514 JUNE 1987, FOUND 1/2" IRON, EAST 20" SPRUCE 48.25', N40E 20" MAPLE 75.25', S65W 20" MAPLE 41.84', N35W 18" SPRUCE 66.20' (L.002 P.36)

C. Description of monument for corner and accessories established to perpetuate locating the position of the corner:

SET ANTRIM COUNTY MONUMENT IN MON. BOX


N71W 33.34' FOUND NAIL S/SIDE LIGHT POLE
N39W 44.48' FOUND NAIL NE/SIDE UTILITY POLE
N38E 75.26' SET NAIL NW/SIDE 28" MAPLE
S62E 44.18' FOUND NAIL & TAG (M.S.H.D.) SW/SIDE 36" WALNUT

Ratified by Peer
Group in accordance
with P.A. 345

Antrim Co. Chairman

Arthur L. Lennox
Arthur L. Lennox
Nov. 18, 1997

Signed by *Neil L. Way*
Surveyor's Michigan License No. 28432

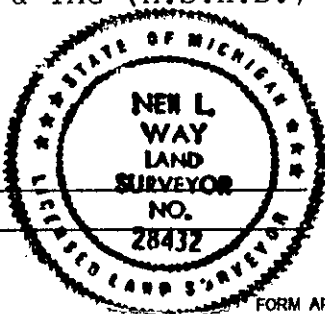

Date 25 NOVEMBER 1997