

**SURVEY & REMONUMENTATION**

FEB 11 1998

Liber 00002 Page 0420

**LAND CORNER RECORDATION CERTIFICATE**  
Filing Requirement of Act 74, Mich. P.A. 1970

**SECTION**

For corners in CENTRAL LAKE TWP.

ANTRIM (County)	Located In:	Corner Code #
1. Public Land Survey S $\frac{1}{4}$ S 14	T <u>31</u> R <u>8W</u>	<u>J-7</u>
	T <u>   </u> R <u>   </u>	<u>   </u>
	T <u>   </u> R <u>   </u>	<u>   </u>
	T <u>   </u> R <u>   </u>	<u>   </u>
2. Property Controlling in Section	S <u>   </u> T <u>   </u> R <u>   </u>	<u>   </u>
	S <u>   </u> T <u>   </u> R <u>   </u>	<u>   </u>
3. Miscellaneous Property in Sec.	S <u>   </u> T <u>   </u> R <u>   </u>	<u>   </u>
	S <u>   </u> T <u>   </u> R <u>   </u>	<u>   </u>

ANTRIM COUNTY MI.  
Register of Deeds  
Recorded

12-15-1997 08:50:48

Manda R. Conway  
REGISTER OF DEEDS

Register of Deeds Stamp & File Number

136

4. Lot No. \_\_\_\_\_, Recorded Plat \_\_\_\_\_  
5. Private Claims \_\_\_\_\_

I, NEIL L. WAY, in a field survey on 19 NOV, 19 97 do hereby state that under requirements of P.A. 74, Michigan P.A. of 1970, the corner points mentioned in lines 1 and 2 above were in conformance with regulations and rules therefore as required in the current manual of survey instructions of the United States Department of the Interior, Bureau of Land Management or by a decree of a Court of Law and for that the corner points mentioned in lines 3, 4 and 5 above were in conformance with the rules of the Michigan Board of Land Surveyors or by a Decree of a Court of Law, established, re-established, monumented, recovered, found as expressed below:

NOTE: Not more than 2 corners, all in the same town and range, may be recorded on this certificate.

	A	B	C	D	E	F	G	H	I	J	K	L	M
1													
2		6		5		4		3		2		1	
3													
4		7		8		9		10		11		12	
5													
6		18		17		16		15		14		13	
7													
8		19		20		21		22		23		24	
9													
10		30		29		28		27		26		25	
11													
12		31		32		33		34		35		36	
13													

A. Description of original monument and accessories and/or subsequent restoration:  
GLO SET BEECH POST APRIL 1857, ELM 34 N19W 8, SUGAR 22 S65 $\frac{1}{4}$ E 24

Ratified by Peer  
Group in accordance  
with P.A. 345  
Antrim Co. Chairman

Arthur L. Lennox

B. Description of corner evidence found and/or method applied in restoring or re-establishing corner:  
FOUND 3/4" IRON PIPE & WIT'S AT  $\pm$  INTERSECTION OF DOWNED FENCES TO NORTH, SOUTH, EAST & WEST

M. FEINDT #3920 SEP 1976, FOUND SPIKE, REPLACED WITH IRON, SOUTH 1.70' 18" MAPLE, S75E 16.7' 16" MAPLE (L.217 P.428)


B. JONES #23514 OCT. 1987, FOUND 1/2" PIPE (RLS#3920 MAP SHOWS IRON PLACED AND CERTAIN WITNESSES - NONE EXIST), N05E 6" MAPLE 11.65', N55W 12" MAPLE 3.55', N87E 10" MAPLE 17.70', S12E 15" MAPLE 23.15' (L.002 P.65)

C. Description of monument for corner and accessories established to perpetuate locating the position of the corner:  
SET ANTRIM COUNTY MONUMENT AT GRADE

N 50 W 3.49' SET NAIL NE/SIDE 12" MAPLE  
N 03 E 11.60' FOUND NAIL & WASHER E/SIDE 8" MAPLE  
N 70 E 17.60' SET NAIL (ABOVE GROWN OVER NAIL & WASHER) S/SIDE 10" MAPLE  
S 13 E 23.00' SET NAIL (BELOW GROWN OVER NAIL & WASHER) W/SIDE 14" MAPLE

Signed by \_\_\_\_\_

Surveyor's Michigan License No. 28432

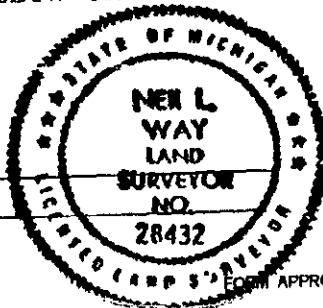

Date 24 NOVEMBER 1997