

FEB 11 1998

Liber 00002 Page 0422

SECTION

LAND CORNER RECORDATION CERTIFICATE
Filing Requirement of Act 74, Mich. P.A. 1970

For corners in CENTRAL LAKE TWP

ANTRIM (County)	Located In:	Corner Code #
1. Public Land Survey S 1/4 S 23 T 31 N R 8 W		J-9
	T R	
	T R	
	T R	
2. Property Controlling In Section.	S T R	
	S T R	
3. Miscellaneous Property in Sec.	S T R	
	S T R	

ANTRIM COUNTY MI.
Register of Deeds
Recorded

12-15-1997 08:51:13

Wanda R. Conway
REGISTER OF DEEDS

Register of Deeds Stamp & File Number

134

4. Lot No. _____, Recorded Plat _____
5. Private Claims _____

I, NEIL L. WAY, in a field survey on 19 NOV., 1997 do hereby state that under requirements of P.A. 74, Michigan P.A. of 1970, the corner points mentioned in lines 1 and 2 above were in conformance with regulations and rules therefore as required in the current manual of survey instructions of the United States Department of the Interior, Bureau of Land Management or by a decree of a Court of Law and /or that the corner points mentioned in lines 3, 4 and 5 above were in conformance with the rules of the Michigan Board of Land Surveyors or by a Decree of a Court of Law; established, re-established, monumented, recovered, found as expressed below:

NOTE: Not more than 2 corners, all in the same town and range, may be recorded on this certificate.

	A	B	C	D	E	F	G	H	I	J	K	L	M
1													
2	6		5		4		3		2		1		
3													
4	7		8		9		10		11		12		
5													
6	18		17		16		15		14		13		
7													
8	19		20		21		22		23		24		
9													
10	30		29		28		27		26		25		
11													
12	31		32		33		34		35		36		
13													

A. Description of original monument and accessories and/or subsequent restoration:


GLO SET BEECH POST OCT. 1856, BEECH 11 N13E 29, BEECH 8 S16 1/4 W 49
M. FEINDT SET CONCRETE MONUMENT, SW CORNER RECORDED PLAT "THE RED PINES"
L. 2 P.164

B. Description of corner evidence found and/or method applied in restoring or reestablishing corner:

FOUND CONCRETE MONUMENT AND WITNESSES AT GRADE

A. LENNOX SEP. 1980 6-8" maple cluster east 12.20'
L. 253 P. 756 6-8" maple cluster north 40.80'
u.p. west 61.60'

Ratified by Peer Group in accordance with P.A. 345 Antrim Co. Chairman

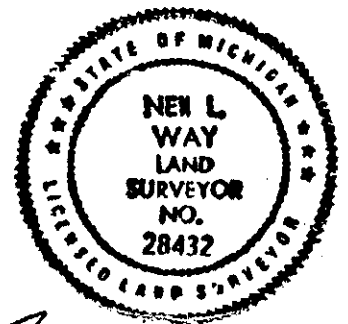

C. Description of monument for corner and accessories established to perpetuate location of the corner:

SET ANTRIM COUNTY MONUMENT, 0.3' BELOW GRADE, 33' +/- EAST OF CENTERLINE BELL ST., 15' SOUTH OF SOUTH EDGE OF CONC. DRIVEWAY (HOUSE #2030)

S70E 13.36' SET NAIL (BELOW GROWN OVER NAIL) S/SIDE 12" MAPLE CLUSTER
NORTH 40.71' SET NAIL W/SIDE 10" MAPLE CLUSTER
WEST 60.78' FOUND NAIL N/SIDE LIGHT POLE
SOUTH 97.41' TOP CENTER OF FIRE HYDRANT

Signed by Neil L. Way
Surveyor's Michigan License No. 28432

Date 24 NOV. 1997