

SURVEY & REMONUMENTATION

FEB 11 1998

Liber 00002 Page 0429

LAND CORNER RECORDATION CERTIFICATE
Filing Requirement of Act 74, Mich. P.A. 1970

For corners in **SECTION**

ANTRIM
 (County)

Located In: CENTRAL LAKE
 Corner Code # _____

ANTRIM COUNTY MI.
 Register of Deeds
 Recorded

12-22-1997 10:11:01

Wanda R. Conway
 REGISTER OF DEEDS

Register of Deeds Stamp & File Number

1. Public Land Survey E 1/4 T.31N R.8W K-6
 SEC 14 T. R. _____
 T. R. _____
 T. R. _____
2. Property Controlling S. T. R. _____
 in Section S. T. R. _____
3. Miscellaneous S. T. R. _____
 Property in Sec. S. T. R. _____

4. Lot No. _____, Recorded Plat _____

5. Private Claims _____

I, RICHARD J. KRAL, in a field survey on 8-20-97, 19.97 do hereby state that under requirements of P.A. 74, Michigan P.A. of 1970, the corner points mentioned in lines 1 and 2 above were in conformance with regulations and rules therefore as required in the current manual of survey instructions of the United States Department of the Interior, Bureau of Land Management or by a decree of a Court of Law and /or that the corner points mentioned in lines 3, 4 and 5 above were in conformance with the rules of the Michigan Board of Land Surveyors or by a Decree of a Court of Law; established, re-established, monumented, recovered, found as expressed below:

NOTE: Not more than 2 corners, all in the same town and range, may be recorded on this certificate.

	A	B	C	D	E	F	G	H	I	J	K	L	M
1													
2	6	5	4	3	2	1							
3													
4	7	8	9	10	11	12							
5													
6	18	17	16	15	14	13							
7													
8	19	20	21	22	23	24							
9													
10	30	29	28	27	26	25							
11													
12	31	32	33	34	35	36							
13													

A. Description of original monument and accessories and/or subsequent restoration:

- K-6 1/4 CORNER COMMON TO SEC. 14 & 13, T31N-R8W
 1857, SUBDIVISION OF TWP., RE-SURVEY BY E.D. ATWATER; SET POST 3 1/2 IN; SUGAR, 11"N74°W, 9 LKS (5.94'); SUGAR 13", S52 1/2°E, 32 LKS (21.12')
- 1906, SURVEY BK. #1, PG. 256 BY B.L. CAUKIN; DEPT. CO. SURVEYOR, USED CORNER, NO DESCRIPTION OF CORNER OR ACCESSORIES
- 1907, RE-SURVEY BK. #1, PG. 268 BY F.S. CHURCH CO. SURVEYOR, FOUND STAKE AT FEN. CORNER; A LARGE STONE BEARS N3 3/4°W, 24.8 FT. (DIST. TO N. SIDE STONE)
- 1987, SURVEY, LIB. 327, PG. 731 AND LCRC, LIB. 2, PG. 65; BY B. JONES SET CORNER FROM LARGE STONE OF F.S. CHURCH SURVEY N 3 3/4°W, 24.8 FT. (TO N. SIDE); 8" IRONWOOD N35°W, 33.88'; L 5" MAPLE, N20°E, 11.27'; 12" TRIP. MAPLE, SOUTH, 7.17'; 4" MAPLE CLUMP, S82°W, 37.80'

B. Description of corner evidence found and/or method applied in restoring or reestablishing corner:

- K-6 1/4 CORNER COMMON TO SEC. 14 & 13, T31N-R8W
 FD. 1/2" IRON ROD & CAP #23514, 121' NORTH OF E. E-W. ASPH. RD.
 PULLED & REPLACED WITH ANTRIM COUNTY MONUMENT (BERNTSEN MODEL G-1 [30" PISTON] WITH G-2 CAP).
 FD. NAIL ON SIDE OF 8" IRONWOOD N30°W, 33.75' (R. 33.88')
 FD. NAIL ON SIDE OF 5" MAPLE N28°E, 11.35' (R. 11.27')
 FD. NAIL ON SIDE 6" TRIPLE MAPLE S05°W, 7.15' (R-7.17')
 FD. NAIL ON SIDE 6" MAPLE S86°W, 37.74' (R. 37.80')
 FD. LARGE STONE (N. SIDE) N16°E, 24.7' (R. 24.8')
 FD. METAL FENCE POST NORTH 3.7'
 NO G.L.O. WITNESS WERE FOUND.


C. Description of monument for corner and accessories established to perpetuate locating the position of the corner:

- K-6 1/4 CORNER COMMON TO SEC. 14 & 13, T31N-R8W
 FD. 1/2" IRON ROD & CAP #23514, 121' NORTH OF E. E-W. ASPH. RD.
 PULLED & REPLACED WITH ANTRIM COUNTY MONUMENT.
 FD. NAIL ON SIDE OF 8" IRONWOOD N30°W, 33.75' (R. 33.88')
 FD. NAIL ON SIDE OF 5" MAPLE N28°E, 11.35' (R. 11.27')
 FD. NAIL ON SIDE 6" TRIPLE MAPLE S05°W, 7.15' (R-7.17')
 FD. NAIL ON SIDE 6" MAPLE S86°W, 37.74' (R. 37.80')
 FD. LARGE STONE (N. SIDE) N16°E, 24.7' (R. 24.8')
 FD. METAL FENCE POST NORTH 3.7'

Ratified by Peer
 Group in accordance
 with P.A. 345
 Antrim Co. Chairman

Arthur L. Lennox

Arthur L. Lennox
 Nov. 18, 1997

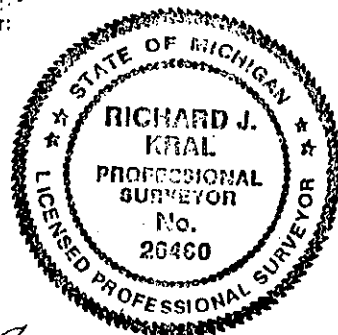

Signed by Richard J. Kral
 Surveyor's Michigan License No. 26460

Date 12-14-97