

**SURVEY &  
REMONUMENTATION**

**FEB 11 1998**

Liber **00002** Page **0430**

**LAND CORNER RECORDATION CERTIFICATE  
Filing Requirement of Act 74, Mich. P.A. 1970**

For corners in **SECTION**                      **CENTRAL LAKE**

ANTRIM Located In:                      Corner Code #                       
(County)

1. Public Land Survey **SE** T. 31N R. 8W K-7  
SEC 14 T.      R.       
T.      R.       
T.      R.     

2. Property Controlling **S** T.      R.       
In Section **S** T.      R.     

3. Miscellaneous **S** T.      R.       
Property in Sec. **S** T.      R.     

ANTRIM COUNTY MI.  
Register of Deeds  
Recorded

12-22-1997 10:11:13

Wanda R. Conway  
REGISTER OF DEEDS

**Register of Deeds Stamp & File Number**

4. Lot No.             , Recorded Plat                                     

5. Private Claims   

A	B	C	D	E	F	G	H	I	J	K	L	M
1												
2	6		5		4		3		2		1	
3												
4	7		8		9		10		11		12	
5												
6	18		17		16		15		14		13	
7												
8	19		20		21		22		23		24	
9												
10	30		29		28		27		26		25	
11												
12	31		32		33		34		35		36	
13												

I, RICHARD J. KRAL, in a field survey on 8-21-97, 1997  
do hereby state that under requirements of P.A. 74, Michigan P.A. of 1970, the corner points mentioned in lines 1 and 2 above were in conformance with regulations and rules therefore as required in the current manual of survey instructions of the United States Department of the Interior, Bureau of Land Management or by a decree of a Court of Law and /or that the corner points mentioned in lines 3, 4 and 5 above were in conformance with the rules of the Michigan Board of Land Surveyors or by a Decree of a Court of Law; established, re-established, monumented, recovered, found as expressed below:


**NOTE: Not more than 2 corners, all in the same town and range, may be recorded on this certificate.**

**A. Description of original monument and accessories and/or subsequent restoration:**  
K-7, CORNER COMMON TO SEC. 14 & 13, 23 & 24, T31N-R8W  
1857, SUBDIVISION OF TWP., RE-SURVEY BY E.D. ATWATER; SET 3" SUGAR POST; 16" BEECH N60°E, 65 LKS. (42.90'); 16" BEECH, S13 1/4°W, 8 LKS. (5.28')  
1906, SURVEY BK. #1, PG. 256 BY B.L. CAUKIN; DEPT. CO. SURVEYOR, FOUND STAKE STANDING AND ONE GOV'T WITNESS.  
1907, RE-SURVEY BK. #1, PG. 268 BY F.S. CHURCH CO. SURVEYOR, FOUND STAKE WEST OF CORNER FENCE POST, & STUMP OF BEECH 16", S13 1/4°W, 8 LKS. (5.28').  
1969, SURVEY BY G.E. OSTLING, SHOWS CORNER, NO DESCRIPTION OR ACCESSORIES.  
1976, SURVEY BY N.B. DEYOUNG, SHOWS CORNER AS A 3/4" IRON PIPE; AND WITNESS TO G.E. OSTLING 1/8 CORNER; 5" MAPLE, WEST, 29.7'; 36" ELM, S22°E, 13.8'.  
1987, SURVEY, LIB. 327, PG. 731 AND LCRC, LIB. 2, PG. 65; BY B. JONES, FOUND 1" HEX IRON AND RING OF STONES; 12" MAPLE, S65°W, 11.48'; 18" MAPLE, S33°E, 16.20'; 14" MAPLE, N16°W, 28.64'; 12" MAPLE, S76°E 18.82'.

**B. Description of corner evidence found and/or method applied in restoring or reestablishing corner:**  
K-7, CORNER COMMON TO SEC. 14 & 13, 23 & 24, T31N-R8W  
FD. 1" HEX IRON IN RING OF STONES AT W. SIDE T FENCE INT. E-W & N.  
PULLED & REPLACED WITH ANTRIM COUNTY MONUMENT (BERNTSEN MODEL G-1 [3" PISTON] WITH G-2 CAP).  
FD. NAIL ON SIDE 12" MAPLE S70°W, 11.34 (R. 11.48')  
FD. NAIL ON SIDE 16" MAPLE S30°E, 16.22' (R. 16.20')  
FD. NAIL & WASHER ON SIDE 10" DEAD MAPLE S70°E, 18.75' (R. 18.82')  
FD. NAIL & WASHER ON SIDE TWIN 22" & 10" MAPLE N23°W, 28.66' (R. 28.64')  
NO G.L.O. WITNESS WERE FOUND.

**C. Description of monument for corner and accessories established to perpetuate locating the position of the corner:**  
K-7, CORNER COMMON TO SEC. 14 & 13, 23 & 24, T31N-R8W  
FD. 1" HEX IRON IN RING OF STONES AT W. SIDE T FENCE INT. E-W & N.  
PULLED & REPLACED WITH ANTRIM COUNTY MONUMENT.  
FD. NAIL ON SIDE 12" MAPLE S70°W, 11.34 (R. 11.48')  
FD. NAIL ON SIDE 16" MAPLE S30°E, 16.22' (R. 16.20')  
FD. NAIL & WASHER ON SIDE 10" DEAD MAPLE S70°E, 18.75' (R. 18.82')  
FD. NAIL & WASHER ON SIDE TWIN 22" & 10" MAPLE N23°W, 28.66' (R. 28.64')  
SET NAIL ON SIDE TWIN 2" & 4" MAPLE, S74°E, 16.42'.

Ratified by Peer  
Group in accordance  
with P.A. 345  
Antrim Co. Chairman  
Arthur L. Lennox  
Nov. 18, 1997

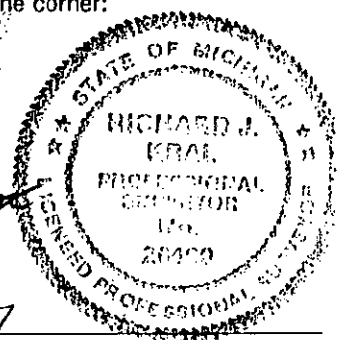

Signed by Richard J. Kral  
Surveyor's Michigan License No. 26460

Date 12-14-97