

SURVEY & REMONUMENTATION

FEB 11 1998

Liber 00002 Page 0432

LAND CORNER RECORDATION CERTIFICATE
Filing Requirement of Act 74, Mich. P.A. 1970

ANTRIM COUNTY MI.
 Register of Deeds
 Recorded

For corners in **SECTION**

CENTRAL LAKE

<u>ANTRIM</u>	Located In:	Corner Code #
(County)		
1. Public Land Survey SE	T.31N R.8W	K-9
SEC 23	T. R.	
	T. R.	
	T. R.	
2. Property Controlling in Section	S. T. R.	
	S. T. R.	
3. Miscellaneous Property in Sec.	S. T. R.	
	S. T. R.	

12-22-1997 10:11:36

Wanda R. Conway
 REGISTER OF DEEDS

Register of Deeds Stamp & File Number

4. Lot No. _____, Recorded Plat _____

5. Private Claims _____

I, RICHARD J. KRAL, in a field survey on 8-20-97, 1997 do hereby state that under requirements of P.A. 74, Michigan P.A. of 1970, the corner points mentioned in lines 1 and 2 above were in conformance with regulations and rules therefore as required in the current manual of survey instructions of the United States Department of the Interior, Bureau of Land Management or by a decree of a Court of Law and /or that the corner points mentioned in lines 3, 4 and 5 above were in conformance with the rules of the Michigan Board of Land Surveyors or by a Decree of a Court of Law; established, re-established, monumented, recovered, found as expressed below:

NOTE: Not more than 2 corners, all in the same town and range, may be recorded on this certificate.

	A	B	C	D	E	F	G	H	I	J	K	L	M
1													
2	6		5		4		3		2		1		
3													
4	7		8		9		10		11		12		
5													
6	18		17		16		15		14		13		
7													
8	19		20		21		22		23		24		
9													
10	30		29		28		27		26		25		
11													
12	31		32		33		34		35		36		
13													

A. Description of original monument and accessories and/or subsequent restoration:
K-9, CORNER COMMON TO SEC. 23, 24 26 & 25, T31N-R8W
 1857, SUBDIVISION OF TWP., RE-SURVEY BY E.D. ATWATER; SET POST 10" BEECH, N69°W, 6 LKS. (3.96'); 12" BEECH, S43 1/2°E, 16 LKS. (10.58')
 1900, SURVEY BK #1, PG. 302, BY F.S. CHURCH; FD STONE & STUMP OF 12" BEECH S43 1/2°E, 16 LKS. (10.56')
 1912, SURVEY BK #1, PG. 330, BY F.S. CHURCH; CO. SURVEYOR, FD A STAKE WITH STONES AROUND IT IN THE MIDDLE OF ROAD.
 1973, SURVEY LIB. 218, PG. 340, BY R.C. DUNN; SHOWS CORNER NO DESC. OR ACCESSORIES.
 1974, SURVEY LIB. 213, PG. 650; BY T.P. O'BRIEN, FD 1" IRON & CAP #12020 (R.C. DUNN)
 1976, SURVEY, BY N.B. DEYOUNG, RESET COR. FROM SURVEY BY #12020, SETTING 1/2" IRON ROD 16" ELM, WEST, 14.52'; 8" CHERRY, N15°W, 37.67'; 14" POPLAR, S15°E, 50.75'.
 1976, LCRC. LIB #230, PG. 410; BY N.B. DEYOUNG; IN N-S. ROAD, ON FENCE E-W. ACCESSORIES SAME AS ON SURVEY OF 1976 ABOVE.
 1976, SURVEY BY N.B. DEYOUNG; SHOWS CORNER, DESC. AND ACCESSORIES SAME AS 1976 SURVEY.
 1887, SURVEY AND 1992 SURVEY; BY N.B. DEYOUNG; FD 1/2" ROD; 8" MAPLE, N20°W, 48.0'; 10" MAPLE, WEST, 14.6'; 8" MAPLE N85°E, 23.5'; 8" MAPLE, S50°E, 28.2'
 1993, LCRC. LIB#2, PG. 163, BY A.L. LENNON; FD 1/2" IRON & CAP #20705 (N.B. DEYOUNG) 16" MAPLE N80°E, 22.4'; 16" MAPLE, WEST, 16.10'; 18" MAPLE, S20°W, 50.40'


B. Description of corner evidence found and/or method applied in restoring or reestablishing corner:
K-9, CORNER COMMON TO SEC. 23, 24 26 & 25, T31N-R8W
 FD. BENT 1/2" IRON ROD (STRAIGHTENED SAME) 3' WEST OF N-S GR. ROAD & 5.5' NORTH OF FENCE LINE TO WEST.
 PULLED & REPLACED WITH ANTRIM COUNTY MONUMENT (BERNTSEN MODEL G-1 [30" PISTON] WITH G-2 CAP).
 FD. NAIL IN TAG #20705 IN FACE 12" MAPLE S84°W, 14.38 (R. 14.52' & 16.10')
 FD. NAIL IN TAG #20705 IN FACE 10" MAPLE N17°W 47.70' (R. 48.0' & 37.67')
 FD. NAIL IN TAG #20705 IN FACE 12" MAPLE N84°E, 23.41' (R. 23.5' & 22.4')
 FD. BLAZE IN FACE 12" MAPLE, SET NAIL ON SIDE S16°W, 53.74' FACE 53.17 (R. 50.40')
 NO G.L.O. WITNESS WERE FOUND.

C. Description of monument for corner and accessories established to perpetuate locating the position of the corner:
K-9, CORNER COMMON TO SEC. 23, 24 26 & 25, T31N-R8W
 FD. BENT 1/2" IRON ROD (STRAIGHTENED SAME) 3' WEST OF N-S GR. ROAD & 5.5' NORTH OF FENCE LINE TO WEST.
 PULLED & REPLACED WITH ANTRIM COUNTY MONUMENT.
 FD. NAIL IN TAG #20705 IN FACE 12" MAPLE S84°W, 14.38 (R. 14.52' & 16.10')
 FD. NAIL IN TAG #20705 IN FACE 10" MAPLE N17°W 47.70' (R. 48.0' & 37.67')
 FD. NAIL IN TAG #20705 IN FACE 12" MAPLE N84°E, 23.41' (R. 23.5' & 22.4')
 FD. BLAZE IN FACE 12" MAPLE, SET NAIL ON SIDE S16°W, 53.74' FACE 53.17 (R. 50.40')
 SET NAIL IN 6" IRONWOOD, S25°E, 51.04'
 SET NAIL IN SIDE 10" MAPLE, S43°E, 28.58'
 FD LARGE SPIKE IN C/L ROAD, S20°E, 4.22'

Ratified by Peer
 Group in accordance
 with P.A. 345
 Antrim Co. Chairman

Arthur L. Lennox
 Nov. 18, 1997

Date 12-14-97

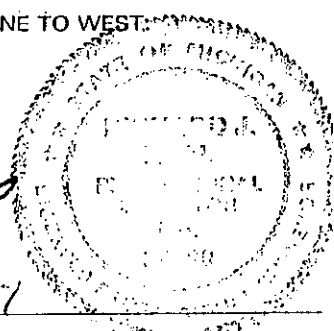

Signed by Richard J. Kral
 Surveyor's Michigan License No. 26460